


LAND CORNER RECORDATION CERTIFICATE
Filing Requirement of Act 74, Mich. PA 1970

For Corners In:				
<u>Midland</u>	Located In		Corner Code #	
(County)				
1. Public Land Survey	T _____ R _____			
	T _____ R _____			
2. Property Controlling in Section	S <u>6</u> T <u>14N</u> R <u>1W</u>		<u>3</u>	
	S <u>6</u> T <u>14N</u> R <u>1W</u>		<u>5</u>	
3. Miscellaneous Property in Section	S _____ T _____ R _____			
	S _____ T _____ R _____			
4. Lot No: _____	Recorded Plat: _____			
5. Private Claims: _____				

Register of Deeds Stamp & File Number

I, Craig W. McVean, in a field survey on March 6, 2012 do hereby state that under requirements of PA 74, Michigan PA of 1970, the corner points mentioned in lines 1 and 2 above were in conformance with regulations and rules therefore as required in the current manual of survey instructions of the United States Department of the Interior, Bureau of Land Management or by a decree of a Court of Law and/or that the corner points mentioned in lines 3, 4 and 5 above were in conformance with the rules of the Michigan Board of Land Surveyors or by a Decree of a Court of Law; established, re-established, monumented, recovered, found as expressed below:

NOTE: Not more than 2 corners, all in the same town and range, may be recorded on this certificate.

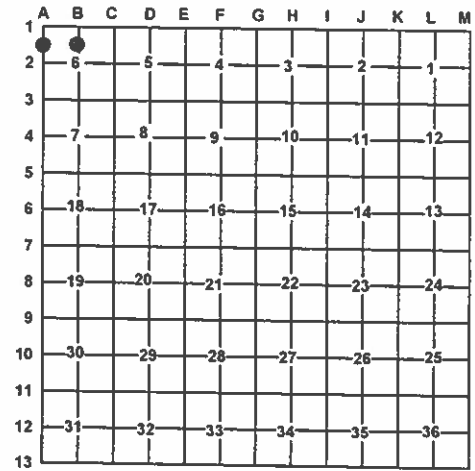

A. Description of original monument and accessories and/or subsequent restoration:

- | | |
|--|--|
| <u>3</u> - 1907 - CSR - L. 1, p. 21 - F. J. Gibbs
Distance East 39.07
- 1923 - F. J. Gibbs - Set Post for corner - 20.06½ - S;
21.06½ - N | <u>5</u> - 1907 - CSR - L. 1, p. 21 - F. J. Gibbs
Distance W. - 39.07; Distance E. - 40.00
- 1923 - F. J. Gibbs - Set post for corner. 21.50 - North;
20.04 - South |
|--|--|

B. Description of corner evidence found and/or method applied in restoring or re-establishing corner:

- | | |
|--|---|
| <u>3</u> - N 1/16 Corner common to Sec. 6, T14N, R1W and Sec. 1, T14N, R2W - Dug 3' dia. area searching for Gibbs' post but nothing was found in mostly dry dirt. Set 2" Alum. Cap on 5/8" x 34" rebar per Standard BLM procedure. North 53± to south edge of flooding. Set corner fits Gibbs' dimensions closely. | <u>5</u> - CN 1/16 Sec. 6 - Dug 2 ½ to 3' dia. area searching for Gibbs' post but nothing was found. Area appears disturbed by ditch construction. Set stamped 2" Alum. Cap on 5/8" x 34" rebar per standard BLM procedure. Centerline of 5± wide ditch N-S is 7' West. Centerline of N-S Dirt road is 47' East. Fits Gibbs' dimension N & S closely. |
|--|---|

C. Description of monument for corner and accessories established to perpetuate locating the position of the corner:

- | | |
|--|---|
| <u>3</u> - Stamped 2" Alum. Cap on 5/8" x 34" long iron rebar
Set Blue Carsonite Post with loc. tag 1' SW
N60°E 9.43' to set N & T in NW side 10" Oak
S65°E 32.32' to set N & T in NE side 12" Oak
S35°W 16.31' to set N & T in E. side 15" Oak
N69°W 14.43' to set N & T in S. side 7" Oak | <u>5</u> - Stamped 2" Alum. Cap on 5/8" x 34" long iron rebar.
Set Blue Carsonite Post with loc. tag 1' SW
S89°W 20.68' to set Spike and Tag in N. side 6" Oak
S61°W 21.54' to set Nail and Tag in SE side 6" R. Maple
S16°E 9.89' to set Spike and Tag in W. side 6" Cherry
S84°E 17.93' to Centerline 3" Ash at Face Blaze |
|--|---|

Signed by: Craig W. McVean
Surveyor's Michigan License No.: 39088

Date: 12/10/2012

