

COMMISSION LAND CORNER RECORDATION CERTIFICATE  
Filing Requirement of Act 74, Mich. P.A. 1970  
REMONUMENTATION

For corners in

Midland (County)

Located In:


Corner Code #

STATE OF MICHIGAN  
MIDLAND COUNTY  
REMONUMENTATION & FILED

30 NOV 93 3:06 P.M.

BEVERLY J THAYER  
REGISTER OF DEEDS

- 1. Public Land Survey T 14N R 1W  
T 14N R 1W
- 2. Property Controlling in Section S T R  
S T R
- 3. Miscellaneous Property in Sec. S T R  
S T R
- 4. Lot No. , Recorded Plat
- 5. Private Claims

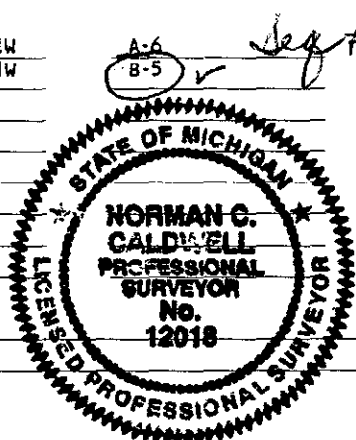

Register of Deeds Stamp & File Number

	A	B	C	D	E	F	G	H	I	J	K	L	I
2	6	5	4	3	2	1							
3													
4	7	8	9	10	11	12							
5	18	17	16	15	14	13							
6													
7													
8	19	20	21	22	23	24							
9													
10	30	29	28	27	26	25							
11													
12	31	32	33	34	35	36							
13													

I, Norman C. Caldwell, in a field survey on May, 19 93, do hereby certify that under requirements of P.A. 74, Michigan P.A. of 1970, the corner points mentioned in lines 1 and 2 above were in conformance with regulations and rules therefore as required in the current manual of survey instructions of the United States Department of the Interior, Bureau of Land Management or by a decree of a Court of Law and/or that the corner points mentioned in lines 3, 4 and 5 above were in conformance with the rules of the Michigan Board of Land Surveyors or by a Decree of a Court of Law; established, re-established, monumented, re-monumented, recovered, found as expressed below:

NOTE: Not more than 4 corners, all in the same town and range, may be recorded on this certificate.

A. Description of original monument and accessories and/or subsequent restoration:

(A-6) 1/4 Cor. Sec. 18, T14N-R1W and Sec. 13, T14N-R2W

Wood post placed by R. Clark, Jr in 1830 in Orig. Range Line Survey S48°W 9 L. (5.94') 17" White Oak N02°W 31 L. (20.46') 16" Elm

Survey by P. Lapham, Recorded in Bk. 1 P. 314, Found 1" capped Pipe: West 33.58' 4" Pine; East 56.00' P. Pole; S40°W 57.00' 4" Pine.

(B-5) 1/4 Cor. Sec. 7 & 18, T14N-R1W

Wood post placed by Austin Burt in 1852 Subdivision Resurvey S16°W 22 L. (14.52') 14" Maple N19°W 20 L. (13.2') 7" Black Ash

Survey by P. Lapham, Recorded in Bk. 1 P. 314, Found 1" capped Pipe: South 53.70' P. Pole; S10°W 42.80' Cor Fnc Post; S50°E 67.09' 3rd Fnc Post.

Survey by G. Gray, Recorded in Bk. 1 P. 685, Found Capped Pipe: SE 103.90' Capped Pipe; North 21.72' S. Edge Pav't; SSE 30.24' Top Cent 18" CMP.

B. Description of corner evidence found and/or method applied in restoring or reestablishing corner:

(A-6) 1/4 Cor. Sec. 18, T14N-R1W and Sec. 13, T14N-R2W

Found 3/8" Iron Rod per Bk. 1 P. 314 over 1" Pipe, Placed Mon. Box.

(B-5) 1/4 Cor. Sec.s 7 & 18, T14N-R1W

Found 3/4" Iron Pipe w/ illegible cap per Bk. 1 Pgs. 314 & 685.

A-6 & B-5 Approved by Midland County Peer Group October 27, 1993.

C. Description of monument for corner and accessories established to perpetuate locating the position of the corner:

(A-6) 1/4 Cor. Sec. 18, T14N-R1W and Sec. 13, T14N-R2W

Fnd 3/8" Iron Rod per Bk. 1 P. 314 over 1" Pipe Placed Mon Box, and is accepted as the best available evidence of the position of the original corner.  
East 56.27' Power Pole (R)  
West 33.46' 8" Red Pine (R)  
S75°W 45.67' N&T 7" Red Pine  
S30°W 72.12' N&T 8" Red Pine

(B-5) 1/4 Cor. Sec.s 7 & 18, T14N-R1W

Fnd 3/4" Iron Pipe w/ illegible cap per Bk. 1 Pgs. 314 & 685, and is accepted as the best available evidence of the position of the original corner.

S75°W 73.14' N&T Power Pole  
S55°E 103.88' N&T Power Pole (R)  
South 72.54' N&T 3/4" Iron Pipe w/ illegible cap (R)  
S40°W 83.09' N&T 8" Scotch Pine  
North 38'± C/L M-20

Signed by

*Norman C. Caldwell*

Date

29 NOV 93

Surveyor's Michigan License No.

12018