

Sequence # 1

LAND CORNER RECORDATION CERTIFICATE  
Filing Requirement of Act 74, Mich. P.A. 1970

For corners in

Midland County

Located In:


REMONUMENTATION  
Corner Code #

STATE OF MICHIGAN  
MIDLAND COUNTY  
REMONUMENTATION & FILED

30 NOV 93 3:07 P.M.

BEVERLY J THAYER  
REGISTER OF DEEDS

- 1. Public Land Survey T 14N R 1W C-6, D-5
- 2. Property Controlling in Section S T R
- 3. Miscellaneous Property in Sec. S T R
- 4. Lot No. , Recorded Plat
- 5. Private Claims

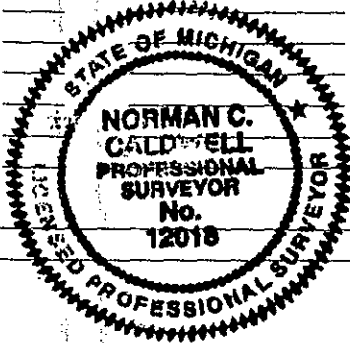

Register of Deeds Stamp & File Number

A	B	C	D	E	F	G	H	I	J	K	L	I
2	6	5	4	3	2	1						
3												
4	7	8	9	10	11	12						
5												
6	16	17	16	15	14	13						
7												
8	18	20	21	22	23	24						
9												
10	30	29	28	27	26	25						
11												
12	31	32	33	34	35	36						
13												

I, Norman C. Caldwell, in a field survey on May, 19 93, do hereby certify that under requirements of P.A. 74, Michigan P.A. of 1970, the corner points mentioned in lines 1 and 2 above were in conformance with regulations and rules therefore as required in the current manual of survey instructions of the United States Department of the Interior, Bureau of Land Management or by a decree of a Court of Law and/or that the corner points mentioned in lines 3, 4 and 5 above were in conformance with the rules of the Michigan Board of Land Surveyors or by a Decree of a Court of Law; established, re-established, monumented, re-monumented, recovered, found as expressed below:

**NOTE: Not more than 4 corners, all in the same town and range, may be recorded on this certificate.**

A. Description of original monument and accessories and/or subsequent restoration:

(C-6) 1/4 Cor., Sec. 17 & 18, T14N-R1W

Wood Post Placed by Austin Burt in 1852 Subd. Resurvey  
S46°W 22 L.(14.52') 8" White Oak  
S89°E 21 L.(13.86') 7" White Ash

Survey by D. Whittier, Recorded in Bk. 1 P. 176, Set 3/4" Pipe: N45°W 49.3' S. End 24" CMP in HDWL; S75°W 58.58' Tag P. Pole; East 33' 3/4" Pipe.

Survey by G. Gray, Recorded in Bk. 1 P. 685, Found 3/4" Pipe: East 6°.15' Oak; SE 135.22' Quad Oak; W'ly 59.49' P. Pole; NW 42.35' Top Cent 24" CMP.

(D-5) 1/4 Cor., Sec. 8 & 17, T14N-R1W

Wood Post placed by Austin Burt in 1852 Subd. Resurvey  
S26°E 24 L.(15.84') 7" Maple  
N10°W 9 L.(5.94') 10" White Pine

Survey by J. Schafer, Recorded in Bk. 1 P. 246, Set 3/4" Iron: North 27.70' CL M-20; S45°W 24.25' CL 4" Gas Marker; S70°E 48.38' N'ly 2" Pipeline Marker.

Survey by J. Jones, Recorded in L.2 P. 100 of Surveys, Found 3/8" Rod: S45°W 96.47' N&T in P. Pole; North 87.21' N&T in P. Pole; S60°E 137.71' N&T in P. Pole.

B. Description of corner evidence found and/or method applied in restoring or reestablishing corner:

(C-6) 1/4 Cor., Sec. 17 & 18, T14N-R1W

Found 3/4" Iron Pipe per Bk. 1 Pgs. 176 & 685, Placed Mon. Box.

(D-5) 1/4 Cor., Sec. 8 & 17, T14N-R1W

Found 3/4" Iron Pipe Per Bk. 1 P. 246, and L. 2 P. 100 of Surveys.

C-6 & D-5 Approved by Midland County Peer Group October 27, 1993.

C. Description of monument for corner and accessories established to perpetuate locating the position of the corner:

(C-6) 1/4 Cor., Sec. 17 & 18, T14N-R1W

Found 3/4" Iron Pipe per B 1, P 176 & 685, Whittier & Gray, Placed Mon Box and is accepted as the best available evidence of the position of the original corner.

S20°E 139.20' Spike in 16" Quad Black Oak(R)  
S89°E 68.19' Spike in 8" Black Oak(R)  
S87°W 59.44' Spike in Power Pole  
N35°W 42.31' Top cen 24" C.M.P.

(D-5) 1/4 Cor., Sec. 8 & 17, T14N-R1W

Found 3/4" Iron Pipe per Bk. 1 P. 246 and L. 2 P. 100 of Surveys and is accepted as the best available evidence of the position of the original corner.

S15°W 57.62' Power Pole  
S65°E 138.02' Power Pole  
N10°E 87.01' Power Pole  
S45°W 123.78' Power Pole  
North 28'+- C/L M-20

Signed by Norman C. Caldwell  
Surveyor's Michigan License No. 12018

Date 24 NOV 93