

Sequence # 1

1993

9

LAND CORNER RECORDATION CERTIFICATE

Filing Requirement of Act 74, Mich. P.A. 1970

STATE OF MICHIGAN
MIDLAND COUNTY
REMONUMENTATION & FILED

30 NOV 93 3:07 P.M.

BEVERLY J THAYER
REGISTER OF DEEDS


For corners in

Midland County

Located In:

REMONUMENTATION
Corner Code #

- 1. Public Land Survey T 14N R 1W G-4 G-5
- T R
- T R
- T R
- 2. Property Controlling S T R
- in Section S T R
- 3. Miscellaneous S T R
- Property in Sec. S T
- 4. Lot No. Recorded Plat
- 5. Private Claims

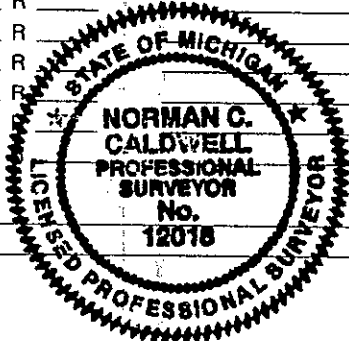

Register of Deeds Stamp & File Number

A	B	C	D	E	F	G	H	I	J	K	L
2	6	5	4	3	2	1					
3											
4	7	8	9	10	11	12					
5											
6	18	17	16	15	14	13					
7											
8	19	20	21	22	23	24					
9											
10	30	29	28	27	26	25					
11											
12	31	32	33	34	35	36					
13											

I, Norman G. Caldwell, in a field survey on May, 19 93, do hereby certify that under requirements of P.A. 74, Michigan P.A. of 1970, the corner points mentioned in lines 1 and 2 above were in conformance with regulations and rules therefore as required in the current manual of survey instructions of the United States Department of the Interior, Bureau of Land Management or by a decree of a Court of Law and/or that the corner points mentioned in lines 3, 4 and 5 above were in conformance with the rules of the Michigan Board of Land Surveyors or by a Decree of a Court of Law; established, re-established, monumented, re-monumented, recovered, found as expressed below:

NOTE: Not more than 4 corners, all in the same town and range, may be recorded on this certificate.

A. Description of original monument and accessories and/or subsequent restoration:

(G-4) 1/4 Cor. Sec. 9 & 10, T14N-R1W
 4" Maple Marked by Austin Burt in 1852 Subd. Resurvey
 N40°W 3 L.(1.98') 8" White Pine
 L.C.R.C. H. Fluharty, Recorded in Bk. 1 P. 424, Found Iron w/ 3/4" Bolt Type Head: N01°E 149.60' P. Pole; S10°W 147.81' P. Pole; N64°E 103.25' 8" W. Pine.
 Survey by Jerry Jones, L. 4, pg. 219

(G-5) Sec. Cor. 9, 10, 15, & 16, T14N-R1W
 Post Placed by Austin Burt in 1852 Subd. Resurvey
 S24°W 7 L.(4.62') 7" White Oak
 N24°E 17 L.(11.22') 8" White Pine
 Survey by H. Fluharty, Recorded in Bk. 1 P. 424, Found 3/4" Pipe in Mon. Box: S30°W 75.49' P. Pole; S18°W 109.27' P. Pole; N30°E 94.63' T. Pole.
 Monument also utilized in surveys of record in L. 1, pg. 557, pg. 558, & pg. 358, L. 3, pg. 73, L. 2, pg. 305, 847, & L. 4, pg. 63.

B. Description of corner evidence found and/or method applied in restoring or reestablishing corner:

(G-4) 1/4 Cor. Sec. 9 & 10, T14N-R1W
 Found 3/4" Iron per Bk. 1 P. 424 & L. 4, pg. 219.

(G-5) Sec. Cor. 9, 10, 15, & 16, T14N-R1W
 Found 3/4" Pipe in Mon Box per Bk. 1 P. 424, and surveys of record in L. 1, pg. 557, 558, pg. 358, L. 3, pg. 73, L. 2, pg. 305, 847 and L. 4, pg. 63.

G-4 & G-5 Approved by Midland County Peer Group October 27, 1993.

C. Description of monument for corner and accessories established to perpetuate locating the position of the corner:

(G-4) 1/4 Cor. Sec. 9 & 10, T14N-R1W
 Found 3/4" Iron per L.C.R.C. Bk. 1, P. 424 and survey in L. 4, pg. 219 and is accepted as the best available evidence of the position of the original corner.
 S09°W 147.90' Power Pole(R)
 N10°W 151.80' Power Pole
 N36°E 146.81' 14" White Pine
 N69°E 69.45' 6" Elm

(G-5) Sec. Cor. 9, 10, 15 & 16, T14N-R1W
 Found 3/4" Pipe in Mon Box per Bk. 1 P. 424 and surveys of record in L. 1, pg. 557, 558, pg. 358, L. 3, pg. 73 L. 2, pg. 305, 847 & L. 4, pg. 63 and is accepted as the best available evidence of the position of the orig. cor.
 S15°E 109.31' Nail in Power Pole(R)
 S30°W 75.57' Power Pole (R)
 N25°E 94.50' Light Support Pole
 S40°E 145.01' N&T Power Pole
 North 31' CL pavement

Signed by Norman G. Caldwell
 Surveyor's Michigan License No. 12018

Date 29 NOV 93