

APPROVED LAND CORNER  
P.A. 345 OF 1990  
MIDLAND COUNTY

Midland County Remonumentation

*Sequence # 2*  
230

7/18/95 LAND CORNER RECORDATION CERTIFICATE  
Filing Requirement of Act 74, Mich. P.A. 1970

For corners in Midland (County) Located In: \_\_\_\_\_ Corner Code # \_\_\_\_\_

1. Public Land Survey	T	<u>14N</u>	R	<u>1W</u>	<div style="border: 1px solid black; border-radius: 50%; padding: 2px; display: inline-block;">G 5</div> H 5
	T	<u>14N</u>	R	<u>1W</u>	
	T	_____	R	_____	
	T	_____	R	_____	
	T	_____	R	_____	
2. Property Controlling in Section	S	_____	T	_____	_____
	S	_____	T	_____	_____
3. Miscellaneous Property in Section	S	_____	T	_____	_____
	S	_____	T	_____	_____
4. Lot No. _____, Recorded Plat _____					
5. Private Claims _____					

STATE OF MICHIGAN  
MIDLAND COUNTY  
REMONUMENTATION & FILED

14 AUG 95 3:02 P.M.

BEVERLY J THAYER  
Register of Deeds Stamp & File Number  
REGISTER OF DEEDS

A	B	C	D	E	F	G	H	I	J	K	L	M
2	6	5	4	3	2	1						
3												
4	7	8	9	10	11	12						
5							●	●				
6	18	17	16	15	14	13						
7												
8	19	20	21	22	23	24						
9												
10	30	29	28	27	26	25						
11												
12	31	32	33	34	35	36						
13												

I, Craig W. McVean, in a field survey on June, 19 95

do hereby certify that under requirements of P.A. 74, Michigan P.A. of 1970, the corner points mentioned in lines 1 and 2 above were in conformance with regulations and rules therefore as required in the current manual of survey instructions of the United States Department of the Interior, Bureau of Land Management or by a decree of a Court of Law and/or that the corner points mentioned in lines 3, 4 and 5 above were in conformance with the rules of the Michigan Board of Professional Surveyors or by a Decree of a Court of Law; established, re-established, monumented, re-monumented, recovered, found as expressed below:

NOTE: Not more than 4 corners, all in the same town and range, may be recorded on this certificate.

A. Description of original monument and accessories and/or subsequent restoration:

G 5 Midland County Remonumentation L.C.R.C. - Remonumentation L. 1, P. 9 - found 3/4" pipe in monument box - Caldwell - 1993.

H 5 Midland County Remonumentation L.C.R.C. - Remonumentation L. 1, P. 11 - found 1" pipe - Caldwell - 1993.


B. Description of corner evidence found and/or method applied in restoring or reestablishing corner:

G 5 Record monument obliterated during 1994-1995 reconstruction of Highway M-20. Reset 2" Midland County brass cap on 5/8" x 24" rebar in monument box per remonumentation L.C.R.C. Witnesses and Witnesses taken before obliteration of recorded monument.

H 5 Recorded monument obliterated during 1994-1995 reconstruction of Highway M-20. Reset 2" Midland County brass cap 5/8" x 24" rebar in monument box per remonumentation L.C.R.C. Witnesses and Witnesses taken before obliteration of recorded monument.

Also see Dossier on file at Midland County Register of Deeds.

Also see Dossier on file at Midland County Register of Deeds.

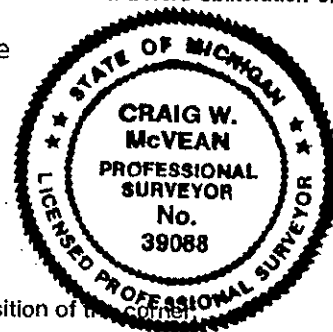

C. Description of monument for corner and accessories established to perpetuate locating the position of the corner:

G 5 2" Midland County brass cap on 5/8" x 24" rebar in monument box.  
S 15° E 109.31' nail in P.P. (R).  
N 25° E 94.50' light support pole (R).  
S 40° E 145.01' nail and tag P.P. (R).  
N. 20° W 166.07' to SE corner garage at House #1516.  
N 20° E 97.18' to centerline concrete right-of-way marker.  
N 50° E 157.96' to SW corner House #1488.  
S 38° E 197.72' to NW corner garage at House #1481.

H 5 2" Midland County brass cap on 5/8" x 24" rebar in monument box.  
S 04° W 65.92' 15" Ash (Oak - R) (R).  
S 29° W 70.43' Triple 30" Ash (Twin Oak - R) (R).  
N 30° W 201.07' to SW corner House #1256.  
S 30° E 157.95' to NW corner sliding on House #1423.  
S 50° E 122.93' to nail and tag in E face U.P.  
S 10° W 60.76' to nail and tag in E face Twin 8" Maple.  
S 58° W 103.93' to nail and tag in W face Twin 18" Maple.

Signed by Craig W. McVean Date 7/6/95  
Surveyor's Michigan License No. 39088