

APPROVED LAND CORNER SURVEY & REMONUMENTATION
 P.A. 345 OF 1990
 MIDLAND COUNTY

115

APR 28 1995
 LAND CORNER RECORDATION CERTIFICATE
 Filing Requirement of Act 74, Mich. P.A. 1970
 COMMISSION

STATE OF MICHIGAN
 MIDLAND COUNTY
 REMONUMENTATION & FILED

For corners in

11 OCT 94 4:09 P.M.

<u>MIDLAND</u> (County)	Located In:	Corner Code #
1. Public Land Survey	T <u>14N</u> R <u>1W</u>	<u>G-9</u>
	T _____ R _____	_____
	T _____ R _____	_____
	T _____ R _____	_____
2. Property Controlling in Section	S _____ T _____ R _____	_____
	S _____ T _____ R _____	_____
3. Miscellaneous Property in Sec.	S _____ T _____ R _____	_____
	S _____ T _____ R _____	_____

BEVERLY J THAYER
 REGISTER OF DEEDS

Register of Deeds Stamp & File Number

4. Lot No. _____, Recorded Plat _____
 5. Private Claims _____

	A	B	C	D	E	F	G	H	I	J	K	L	A
2	6		5		4		3		2		1		
3													
4	7		8		9		10		11		12		
5													
6	18		17		16		15		14		13		
7													
8	19		20		21		22		23		24		
9													
10	30		29		28		27		26		25		
11													
12	31		32		33		34		35		36		
13													

I, PAUL B. LAPHAM, in a field survey on JULY, 19 94, do hereby certify that under requirements of P.A. 74, Michigan P.A. of 1970, the corner points mentioned in lines 1 and 2 above were in conformance with regulations and rules therefore as required in the current manual of survey instructions of the United States Department of the Interior, Bureau of Land Management or by a decree of a Court of Law and/or that the corner points mentioned in lines 3, 4 and 5 above were in conformance with the rules of the Michigan Board of Land Surveyors or by a Decree of a Court of Law; established, re-established, monumented, re-monumented, recovered, found as expressed below:

NOTE: Not more than 4 corners, all in the same town and range, may be recorded on this certificate.

A. Description of original monument and accessories and/or subsequent restoration:

- G-9: Section Corner common to Sections 21, 22, 27 & 28
- 1852 - Austin Burt, W. Pine 12" N 81°E 14 lks, W. Pine 12" S 80-1/2°W 53 lks
- 10/NOV/11 - Gibbs, R.R. Iron and Post, P. 318-319
- 02/14/74 - Paul Lapham, Found 1/2 pipe L.C.R.C. 274
- (1) S 55°E, 55.90' - Power Pole
- (2) S 25°W, 118.63' - 6" White Pine
- (3) WEST, 34.40' - Power Pole

B. Description of corner evidence found and/or method applied in restoring or reestablishing corner:


- G-9: Section Corner common to Sections 21, 22, 27 & 28
- Found 1/2" re-bar stuck in 2" x 12" pipe. Excavated to 3 feet and found no further evidence
- Found Recorded Witnesses 1 & 3.

Accepted as best available evidence of the position of the original corner & replaced with Standard Monument.

Corner, G-9 was approved for remonumentation at a Peer Review Committee Meeting on 9-27, 19 94.

C. Description of monument for corner and accessories established to perpetuate locating the position of the corner:

- G-9: Section Corner common to Sections 21, 22, 27 & 28
- Set 5/8" x 18" re-rod with brass cap stamped "Midland Co. Remon. Cor. PS 9433" in Monument Box.
- S 32°W, 120.8' - Nail & Tag in Power Pole
- N 30°E, 100.29' - Nail & Tag in 16" Oak
- S 55°E, 55.90' - Nail & Tag in Power Pole (1)
- WEST, 34.40' - Nail & Tag in Power Pole (3)

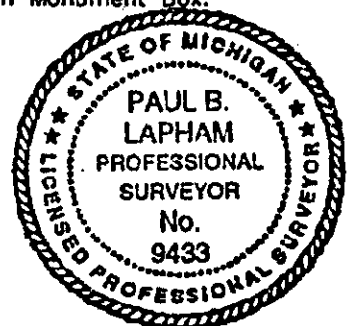

Signed by Paul B. Lapham
 Surveyor's Michigan License No. 9433

Date 9-30-94