

**SURVEY &
REMONUMENTATION**

**APPROVED LAND CORNER
P.A. 345 OF 1990
MIDLAND COUNTY**

APR 28 1995

**COMMISSION
LAND CORNER RECORDATION CERTIFICATE
Filing Requirement of Act 74, Mich. P.A. 1970**

183

For corners in

| | | |
|---------------------------------------|--------------------------|---------------|
| <u>MIDLAND</u> (County) | Located In: | Corner Code # |
| 1. Public Land Survey | T <u>14N</u> R <u>1W</u> | <u>G-11</u> |
| | T _____ R _____ | _____ |
| | T _____ R _____ | _____ |
| | T _____ R _____ | _____ |
| 2. Property Controlling in Section | S _____ T _____ R _____ | _____ |
| | S _____ T _____ R _____ | _____ |
| 3. Miscellaneous Property in Sec. | S _____ T _____ R _____ | _____ |
| | S _____ T _____ R _____ | _____ |
| 4. Lot No. _____, Recorded Plat _____ | | |
| 5. Private Claims _____ | | |


STATE OF MICHIGAN
MIDLAND COUNTY
REMONUMENTATION & FILED

21 DEC 94 11:17 A.M.

BEVERLY J THAYER
REGISTER OF DEEDS

Register of Deeds Stamp & File Number

I, PAUL B. LAPHAM, in a field survey on NOVEMBER, 19 94, do hereby certify that under requirements of P.A. 74, Michigan P.A. of 1970, the corner points mentioned in lines 1 and 2 above were in conformance with regulations and rules therefore as required in the current manual of survey instructions of the United States Department of the Interior, Bureau of Land Management or by a decree of a Court of Law and/or that the corner points mentioned in lines 3, 4 and 5 above were in conformance with the rules of the Michigan Board of Land Surveyors or by a Decree of a Court of Law; established, re-established, monumented, re-monumented, recovered, found as expressed below:

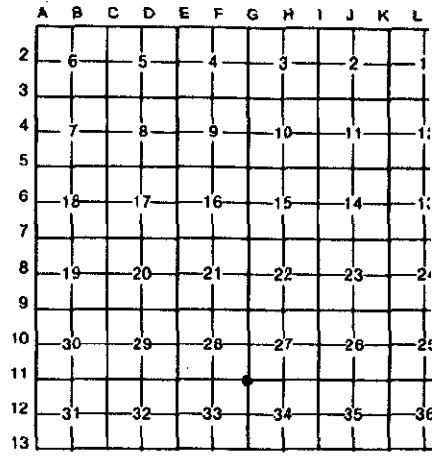

NOTE: Not more than 4 corners, all in the same town and range, may be recorded on this certificate.

A. Description of original monument and accessories and/or subsequent restoration:

- | | |
|--|---|
| 1852 AUSTIN BURT, NO C.S.R. WIT.-MAPLE 10" S35°W 8 LKS. MAPLE 8" N62°E 21 LKS. | 10-20-80 PAUL LAPHAM, L.C.R.C. #527 FOUND 5/8" ROD AT RD. INTERSECTION WIT.-(2)N45°W 51.90' POWER POLE (4)N45°E 43.12' POWER POLE (5)S30°E 103.62' 8" OAK CLUMP |
| 12-6-71 DAVID WHITTIER, L.C.R.C. #114 1 1/2" PIPE WIT.-(1)S60°W @ 15" ASH 52.0' (2)N45°W FACE OF POWER POLE 51.5' (3)S30°W @ 10" PINE 136.6' | |

B. Description of corner evidence found and/or method applied in restoring or reestablishing corner:

G-11 SECTION CORNER COMMON TO SECTIONS 27, 28, 33, & 34
FOUND 5/8" ROD INSIDE A 1 1/2"x36" PIPE. EXCAVATED TO 3' DEPTH. DID NOT FIND FURTHER EVIDENCE.
FOUND RECORDED WITNESSES - (2), (4), & (5).

Accepted as best available evidence of the position of the original corner & replaced with Standard Monument.

Corner, G-11 was approved for remonumentation at a Peer Review Committee Meeting on 12-05, 1994.

C. Description of monument for corner and accessories established to perpetuate locating the position of the corner:

G-11: Corner common to Sections 27, 28, 33 & 34
Set 5/8" x 36" re-rod with brass cap stamped "Midland Co. Remon. Cor. PS 9433" in Monument Box.
WITNESSES:
N45°W 51.90' - N&T IN POWER POLE (2)
N45°E 43.12' - N&T IN POWER POLE (4)
S30°E 103.62' N&T IN 8" OAK CLUMP (5)
S30°W 57.90' FACE OF 4" PINE



Signed by Paul B. Lapham
Surveyor's Michigan License No. 9433

Date 12/19/94