

SURVEY & REMONUMENTATION
 APPROVED LAND CORNER
 P.A. 345 OF 1990
 MIDLAND COUNTY

APR 28 1995

9/27/94 JLF

LAND CORNER RECORDATION CERTIFICATE
 Filing Requirement of Act 74, Mich. P.A. 1970

117
 STATE OF MICHIGAN
 MIDLAND COUNTY
 REMONUMENTATION & FILED

11 OCT 94 4:10 P.M.

BEVERLY J THAYER
 REGISTER OF DEEDS

Register of Deeds Stamp & File Number


For corners in

MIDLAND (County)	Located In:	Corner Code #
1. Public Land Survey	T <u>14N</u> R <u>1W</u>	<u>H-7</u>
	T _____ R _____	_____
	T _____ R _____	_____
	T _____ R _____	_____
2. Property Controlling in Section	S _____ T _____ R _____	_____
	S _____ T _____ R _____	_____
3. Miscellaneous Property in Sec.	S _____ T _____ R _____	_____
	S _____ T _____ R _____	_____

4. Lot No. _____, Recorded Plat _____
 5. Private Claims _____

I, PAUL B. LAPHAM, in a field survey on JULY, 19 94, do hereby certify that under requirements of P.A. 74, Michigan P.A. of 1970, the corner points mentioned in lines 1 and 2 above were in conformance with regulations and rules therefore as required in the current manual of survey instructions of the United States Department of the Interior, Bureau of Land Management or by a decree of a Court of Law and/or that the corner points mentioned in lines 3, 4 and 5 above were in conformance with the rules of the Michigan Board of Land Surveyors or by a Decree of a Court of Law; established, re-established, monumented, re-monumented, recovered, found as expressed below:

NOTE: Not more than 4 corners, all in the same town and range, may be recorded on this certificate.

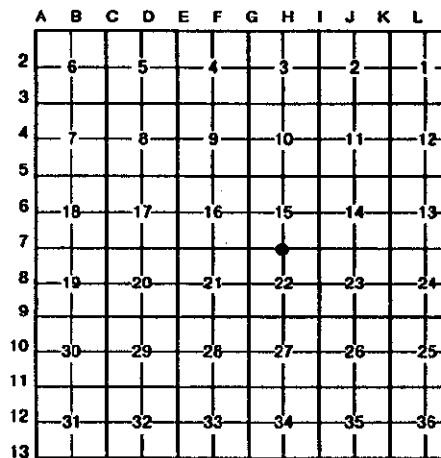

A. Description of original monument and accessories and/or subsequent restoration:

H-7: 1/4 Corner common to Sections 15 & 22
 1852 - Austin Burt, W. Pine 16" S 20°E 97 lks, W. Pine 8" N 21°E 37 lks
 10/NOV/11 - Gibbs, Set Gas pipe at Avg. Dist. on True line P. 318-319
 01/12/84 Edmonds Eng. Found Mon. Box P.A. (132) 3-657
 (1) NW, 40.2' - Nail in Util. Pole (2) N 10°E, 64.5' - face, 8" White Pine
 10/01/74 - Herbut Fluharty, Fd. 1/2" pipe in Mon. Box L.C.R.C. 337 (132) 1-742
 (3) N 45°E, 94.75' - Power Pole (1) N 35°W, 40.16' - Power Pole (4) S 25°W, 35.06' - 6" Oak
 04/04/78 - Jerome Schafer, Fd. 3/4" pipe in Mon. Box (132) 2-508
 (4) S 35°W, 35.0' N&T, 8" Oak (1) N 40°W, 40.19' - N&T, Power Pole (5) @ Paved Road
 04/29/83 - Duane Ledy, Fd. 3/4" pipe (132) 3-638
 (3) N 45°E, 94.75' - Power Pole (1) N 45°W, 40.16' - Power Pole (4) S 25°W, 35.04' - 6" Oak

B. Description of corner evidence found and/or method applied in restoring or reestablishing corner:


H-7: 1/4 Corner common to Sections 15 & 22
 Found 2" x 30" pipe. Excavated to 3 feet, found no further evidence.
 Found Recorded Witnesses 1, 2, 3 & 4.

Accepted as best available evidence of the position of the original corner & replaced with Standard Monument.

Corner, H-7 was approved for remonumentation at a Peer Review Committee Meeting on 9-27, 19 94

C. Description of monument for corner and accessories established to perpetuate locating the position of the corner:

H-7: 1/4 Corner common to Sections 15 & 22
 Set 5/8" x 18" re-rod with brass cap stamped "Midland Co. Remon. Cor. PS 9433" in Monument Box.
 N 08°E, 81.10' - N&T, 10" Oak
 N 45°W, 40.16' - N&T, Power Pole (1)
 N 45°E, 94.75' - N&T, Power Pole (3)
 S 25°W, 35.04' - N&T, 6" Oak (4)

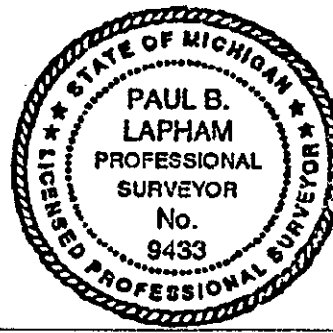

Signed by Paul B. Lapham
 Surveyor's Michigan License No. 9433

Date 9-30-94