

Sequence # 1

LAND CORNER RECORDATION CERTIFICATE
Filing Requirement of Act 74, Mich. P.A. 1970

12

For corners in

Midland County

Located In:

Corner Code #


- 1. Public Land Survey T 14N R 1W
- 2. Property Controlling in Section S T R
- 3. Miscellaneous Property in Sec. S T R
- 4. Lot No. Recorded Plat
- 5. Private Claims

1-4 (1-5)

STATE OF MICHIGAN
MIDLAND COUNTY
RECORDATION & FILED

30 NOV 93 3:08 P.M.

BEVERLY J THAYER
REGISTER OF DEEDS

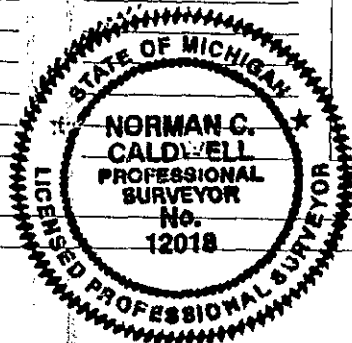

Register of Deeds Stamp & File Number

I, Norman C. Caldwell, in a field survey on May 19 93 do hereby certify that under requirements of P.A. 74, Michigan P.A. of 1970, the corner points mentioned in lines 1 and 2 above were in conformance with regulations and rules therefore as required in the current manual of survey instructions of the United States Department of the Interior, Bureau of Land Management or by a decree of a Court of Law and/or that the corner points mentioned in lines 3, 4 and 5 above were in conformance with the rules of the Michigan Board of Land Surveyors or by a Decree of a Court of Law; established, re-established, monumented, re-monumented, recovered, found as expressed below:

	A	B	C	D	E	F	G	H	I	J	K	L
2	6	5	4	3	2	1						
3												
4	7	8	9	10	11	12						
5												
6	18	17	16	15	14	13						
7												
8	19	20	21	22	23	24						
9												
10	30	29	28	27	26	25						
11												
12	31	32	33	34	35	36						
13												

NOTE: Not more than 4 corners, all in the same town and range, may be recorded on this certificate.

A. Description of original monument and accessories and/or subsequent restoration:

(1-4) 1/4 Cor, Sec. 10 & 11, T14N-R1W

Post placed by Austin Burt in 1852 Subd. Resurvey N05°W 84 L. (55.44') 10" Pepperage N89°E 56 L. (36.96') 6" Tamarack

L.C.R.C. by J. Schafer, Recorded in Bk.1 P. 259, Found 3/4" Pipe 22" Deep, Raised w/ 3/4" Pipe: S80°E 46.23' N&D in 9" R. Pine; N30°E 83.84' N&D in T. Pole; West 33.00' 3/4" Iron Pipe.

L.C.R.C. by H. Fluharty, Recorded in Bk. 1 P. 424, Found 3/4" Pipe: N16°W 107.33' 17" Tw. Oak; N31°E 83.81' P. Pole; S77°E 46.89' (?) 12" R. Pine. (Surveys in L. 4, P. 39, L. 1, P. 484 & L. 4, P. 595

(1-5) Sec, Cor, 10, 11, 14, & 15, T14N-R1W

Wood Post placed by Austin Burt in 1852 Subd. resurvey N55°W 4 L. (2.64') 6" Aspen S45°E 4 L. (2.64') 5" Aspen

L.C.R.C. by D. Whittier, Recorded in Bk. 1 P. 170, Found 1/2" Pipe in Mon. Box: North 26.02' edge of Conc. Pav't M-20; S30°E 86.27' N&D in P. Pole; S35°W 60.88' N&D in 15" Maple.

L.C.R.C. by H. Fluharty, Recorded in Bk.1 P. 424, Found 1/2" Pipe in Mon. Box: S30°W 93.51' P. Pole; S22°E 86.25' P. Pole; N88°E 30.52' Rd. Marker. L.C.R.C. by P. Lapham, Recorded in Bk. 1 P. 623, Found 1/2" Pipe in Mon. Box: S30°W 60.77' 12" Tw. Maple; S30°E 86.24' P. Pole; North 37.20' CL M-20. (Surveys in L. 4, P. 39, L. 4, P. 595, L. 4, P. 464 L. 4, P. 864 & L. 1, P 202

B. Description of corner evidence and/or method applied in restoring or reestablishing corner:

(1-4) 1/4 Cor, Sec. 10 & 11, T14N-R1W

Found 3/4" Iron Pipe per Bk.1 Pgs. 259 & 424, Placed Mon. Box.

(1-5) Sec, Cor, 10, 11, 14 & 15, T14N-R1W

Found 1/2" Pipe in Mon. Box per Bk. 1 Pgs. 170, 424, and 623.

C. Description of monument for corner and accessories established to perpetuate locating the position of the corner:

(1-4) 1/4 Cor, Sec. 10 & 11, T14N-R1W

Fnd 3/4" Iron Pipe per Bk. 1 Pgs. 259 & 424 Placed Mon Box, and is accepted as the best available evidence of the position of the original corner. N22°E 83.85' Tele. Pole(R) S80°E 46.25' 14" Red Pine(R) S50°E 48.75' 8" Red Pine West 35.46' Fence Corner(W&N)

(1-5) Sec, Cor, 10, 11, 14 & 15, T14N-R1W

Fnd 1/2" Pipe in Mon Box per Bk.1 Pgs. 170, 424 & 623 and is accepted as the best available evidence of the position of the original corner.

S28°W 60.82' 14" Maple(R) S30°W 93.57' Power Pole(R) S58°W 98.52' 6" Oak S18°E 86.07' Power Pole(R) North 37.2' CL M-20

Signed by *Norman C. Caldwell*

Date 24 NOV 93

Surveyor's Michigan License No. 12018