

**SURVEY &
REMONUMENTATION**

APPROVED LAND CORNER
P.A. 345 OF 1990
MIDLAND COUNTY

APR 28 1995

LAND CORNER RECORDATION CERTIFICATE
Filing Requirement of Act 74, Mich. P.A. 1970

116
STATE OF MICHIGAN
MIDLAND COUNTY
REMONUMENTATION & FILED

11 OCT 94 4:09 P.M.

BEVERLY J THAYER
REGISTER OF DEEDS

Register of Deeds Stamp & File Number

For corners in

<u>MIDLAND</u> (County)	Located In:	Corner Code #
1. Public Land Survey	T <u>14N</u> R <u>1W</u>	<u>1-7</u>
	T _____ R _____	_____
	T _____ R _____	_____
	T _____ R _____	_____
2. Property Controlling in Section	S _____ T _____ R _____	_____
	S _____ T _____ R _____	_____
3. Miscellaneous Property in Sec.	S _____ T _____ R _____	_____
	S _____ T _____ R _____	_____
4. Lot No. _____, Recorded Plat _____		
5. Private Claims _____		

	A	B	C	D	E	F	G	H	I	J	K	L	M
2	6	5	4	3	2	1							
3													
4	7	8	9	10	11	12							
5													
6	18	17	16	15	14	13							
7													
8	19	20	21	22	23	24							
9													
10	30	29	28	27	26	25							
11													
12	31	32	33	34	35	36							
13													

I, PAUL B. LAPHAM, in a field survey on JULY, 19 94, do hereby certify that under requirements of P.A. 74, Michigan P.A. of 1970, the corner points mentioned in lines 1 and 2 above were in conformance with regulations and rules therefore as required in the current manual of survey instructions of the United States Department of the Interior, Bureau of Land Management or by a decree of a Court of Law and/or that the corner points mentioned in lines 3, 4 and 5 above were in conformance with the rules of the Michigan Board of Land Surveyors or by a Decree of a Court of Law; established, re-established, monumented, re-monumented, recovered, found as expressed below:

NOTE: Not more than 4 corners, all in the same town and range, may be recorded on this certificate.

A. Description of original monument and accessories and/or subsequent restoration:

- I-7: Section Corner common to Sections 14, 15, 22 & 23
1852 - Austin Burt, B. Ash 14" N 22°E 25 lks, Elm 16" S 37°W 41 lks
10/NOV/11 - Gibbs, Wagon Wheel Boxing, Old Corner P. 318-319
09/24/74 - Herbert Fluharty, Fd 1/2" pipe in Mon. Box (132) 1-742, L.C.R.C. 337
(1) N 35°W, 80.52' - Power Pole (2) S 50°W, 59.56' - Power Pole (3) S 45°E, 43.12' - Tele. Pole
04/29/83 - Duane Ledy, Fd. 3/4" pipe in Mon. Box (132) 3-638
Witnesses as above
05/16/86 - Edmonds Eng. Found Monument Box (132) 3-658
(2) SW, 59.0' - face, Util. Pole (1) NW, 80.0' - face, Util. Pole
07/10/90 - Ledy, Found 3/4" pipe (132) 4-707
(1) NW, 80.55' - Nail, Power Pole (4) SE, 39.15' - PK, Power Pole
(2) SW, 59.70' - Nail, Power Pole (5) NE, 46.80' - 4" pipe

B. Description of corner evidence found and/or method applied in restoring or reestablishing corner:


- I-7: Section Corner common to Sections 14, 15, 22 & 23
Found 3/4" x 24" pipe. Excavated to 2-1/2 feet, found 4" iron pipe, (Wagon Wheel Box?).
Found Recorded Witnesses 1, 2, 4 & 5

Accepted as best available evidence of the position of the original corner & replaced with Standard Monument.

Corner, I-7 was approved for remonumentation at a Peer Review Committee Meeting on 9-27, 19 94.

C. Description of monument for corner and accessories established to perpetuate locating the position of the corner:

- I-7: Section Corner common to Sections 14, 15, 22 & 23
Set 5/8" x 18" re-rod with brass cap stamped "Midland Co. Remon. Cor. PS 9433" in 4" Pipe in Monument Box.
N 35°W, 80.52' - Power Pole (1)
S 50°W, 59.56' - Power Pole (2)
S 34°E, 39.15' - Power Pole (4)
N 62°E, 46.80' - 4" Pipe (5)

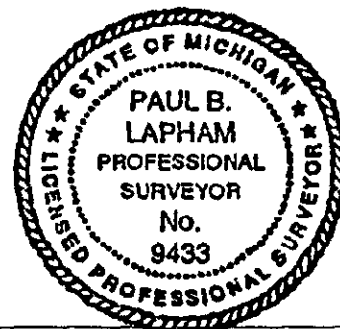

Signed by Paul B. Lapham
Surveyor's Michigan License No. 9433

Date 9-30-94