

**SURVEY &  
REMONUMENTATION**

APPROVED LAND CORNER  
P.A. 345 OF 1990  
MIDLAND COUNTY

APR 28 1995

112

**COMMISSION  
LAND CORNER RECORDATION CERTIFICATE  
Filing Requirement of Act 74, Mich. P.A. 1970**

For corners in

MIDLAND  
(County)

Located In:

Corner Code #

- |                                       |                          |             |
|---------------------------------------|--------------------------|-------------|
| 1. Public Land Survey                 | T <u>14N</u> R <u>1W</u> | <u>J-13</u> |
|                                       | T _____ R _____          | _____       |
|                                       | T _____ R _____          | _____       |
|                                       | T _____ R _____          | _____       |
| 2. Property Controlling<br>In Section | S _____ T _____ R _____  | _____       |
|                                       | S _____ T _____ R _____  | _____       |
| 3. Miscellaneous<br>Property in Sec.  | S _____ T _____ R _____  | _____       |
|                                       | S _____ T _____ R _____  | _____       |

STATE OF MICHIGAN  
MIDLAND COUNTY  
REMONUMENTATION & FILED

11 OCT 94 4:08 P.M.

BEVERLY J THAYER  
REGISTER OF DEEDS

Register of Deeds Stamp & File Number

4. Lot No. \_\_\_\_\_, Recorded Plat \_\_\_\_\_  
5. Private Claims \_\_\_\_\_

A	B	C	D	E	F	G	H	I	J	K	L	M
2	6	5	4	3	2	1						
3												
4	7	8	9	10	11	12						
5												
6	18	17	16	15	14	13						
7												
8	19	20	21	22	23	24						
9												
10	30	29	28	27	26	25						
11												
12	31	32	33	34	35	36						
13												

I, PAUL B. LAPHAM, in a field survey on JULY, 19 94, do hereby certify that under requirements of P.A. 74, Michigan P.A. of 1970, the corner points mentioned in lines 1 and 2 above were in conformance with regulations and rules therefore as required in the current manual of survey instructions of the United States Department of the Interior, Bureau of Land Management or by a decree of a Court of Law and/or that the corner points mentioned in lines 3, 4 and 5 above were in conformance with the rules of the Michigan Board of Land Surveyors or by a Decree of a Court of Law; established, re-established, monumented, re-monumented, recovered, found as expressed below:

**NOTE: Not more than 4 corners, all in the same town and range, may be recorded on this certificate.**


A. Description of original monument and accessories and/or subsequent restoration:  
J-13: South 1/4 Corner, Section 35  
1852 - Austin Burt, B. Ash 10" N 54°E 12 lks, Elm B" N 33°W, 7 lks  
No C.S.R.  
07/12/72 - David Whittier, Fd. 3/4" pipe, Replaced with 1-1/2" pipe, 36" long L.C.R.C. 162  
(1) NORTH, Tag in Southerly 6" Ash (Clump of 3) 30.10'  
(2) N 40°E, tag in 12" Pine, 34.08'  
(3) S 45°E, tag in 30" Oak, 58.12'

B. Description of corner evidence found and/or method applied in restoring or reestablishing corner:  
J-13: South 1/4 Corner, Section 35  
Found 1-1/2" x 36" pipe. Excavated to 3 feet and found no further evidence.  
Found Recorded Witnesses 1, 2 & 3.

Accepted as best available evidence of the position of the original corner & replaced with Standard Monument.

Corner, J-13 was approved for remonumentation at a Peer Review Committee Meeting on 9-27-94, 1994.

C. Description of monument for corner and accessories established to perpetuate locating the position of the corner:  
J-13: South 1/4 Corner, Section 35  
Set 5/8" x 18" re-rod with brass cap stamped "Midland Co. Remon. Cor. PS 9433" in Monument Box.  
N 60°W, 13.45' - Tag in 12" Poplar  
NORTH, Tag in Southerly 6" Ash (Clump of 3) 30.10' (1)  
N 40°E, tag in 12" Pine, 34.08' (2)  
S 45°E, tag in 30" Oak, 58.12' (3)

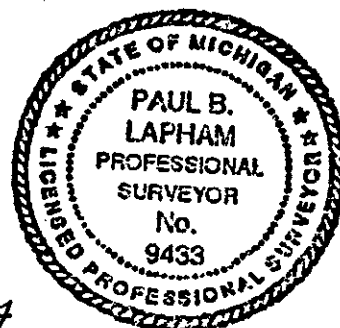

Signed by Paul B. Lapham  
Surveyor's Michigan License No. 9433

Date 9-30-94