

LAND CORNER RECORDATION CERTIFICATE
Filing Requirement of Act 74, Mich. P.A. 1970

STATE OF MICHIGAN
MIDLAND COUNTY
REMONUMENTATION & FILED

20 DEC 96 2:07 P.M.

BEVERLY J THAYER
REGISTER OF DEEDS

Register of Deeds Stamp & File Number

For corners in

MIDLAND
(County)

Located in:

Corner Code #

- | | | |
|------------------------------------|-----------------------|--------------|
| 1. Public Land Survey | T 15N R 1W | K-13 |
| | T 14N R 1W | <u>(K-1)</u> |
| | T R | |
| | T R | |
| 2. Property Controlling in Section | S T R | |
| | S T R | |
| 3. Miscellaneous Property in Sec. | S T R | |
| | S T R | |

4. Lot No. _____, Recorded Plat _____
5. Private Claims _____

I, PAUL B. LAPHAM, in a field survey on NOVEMBER, 1995 do hereby state that under requirements of P.A. 74, Michigan P.A. of 1970, the corner points mentioned in lines 1 and 2 above were in conformance with regulations and rules therefore as required in the current manual of survey instructions of the United States Department of the Interior, Bureau of Land Management or by a decree of a Court of Law and /or that the corner points mentioned in lines 3, 4 and 5 above were in conformance with the rules of the Michigan Board of Land Surveyors or by a Decree of a Court of Law, established, re-established, monumented, recovered, found as expressed below:

NOTE: Not more than 2 corners, all in the same town and range, may be recorded on this certificate.

1	A	B	C	D	E	F	G	H	I	J	K	L	M
2	6		5		4		3		2		1		
3													
4	7		8		9		10		11		12		
5													
6	18		17		16		15		14		13		
7													
8	19		20		21		22		23		24		
9													
10	30		29		28		27		26		25		
11													
12	31		32		33		34		35		36		
13													

A. Description of original monument and accessories and/or subsequent restoration:

1852 BURT
COR. OF SECS. 35-36
WIT.-HEMLOCK 24" N51° 1/3E 60 LKS.
W OAK 14" N63°W 12 LKS.

1-7-77 LAPHAM, L.C.R.C.
FOUND 3/4" PIPE
WIT.-N45°E, 29.53' - 5" MAPLE
S85°E, 29.52' - 8" RED OAK
S45°W, 54.87' - 6" MAPLE
EAST, FENCE

8-30-90 MACDONALD, (132) 4-686
FOUND 1/2" REBAR
WIT.-S75°E, 28.85' - NAIL IN 10" OAK
N56°E, 30.45' - NAIL IN 8" MAPLE
S74°W, 21.45' - NAIL IN 14" OAK
S46°W, 53.45' - NAIL IN 12" MAPLE

*K-13, T15N-R1W IS COMMON
WITH K-1, T14N-R1W*

B. Description of corner evidence found and/or method applied in restoring or reestablishing corner:

FOUND 1/2x36" IRON BAR (NOT 3/4" PIPE) APPROXIMATELY 1 1/2 FEET S.W. OF A SPIKE. NAIL FIT 1977 WITNESSES APPROXIMATELY, 1/2" BAR FIT 1990 WITNESSES. ACCEPTED 1/2" BAR AS CORNER, *COMMON CORNER*


Corner, *AND K-1* K-13 was approved for remonumentation at a Peer Review Committee Meeting on 11-12, 1996.

C. Description of monument for corner and accessories established to perpetuate locating the position of the corner:

SET 3/4"x18" GAS PIPE WITH BRASS CAP STAMPED "MIDLAND CO. REMON. COR. P.S. 9433".
ACCEPTED AS BEST AVAILABLE EVIDENCE OF THE ACCEPTED POSITION OF THE CORNER.

WITNESSES:
N45°E, 30.48' - NAIL & TAG IN 8" MAPLE (OBT)
S85°E, 28.80' - NAIL & TAG IN 13" RED OAK (OBT)
S45°W, 53.46' - NAIL & TAG IN 11" TWIN MAPLE (OBT)
S65°W, 21.44' - NAIL & TAG IN 16" RED OAK (OBT)

*NOTE: K-13, T15N-R1W IS COMMON
WITH K-1, T14N-R1W*

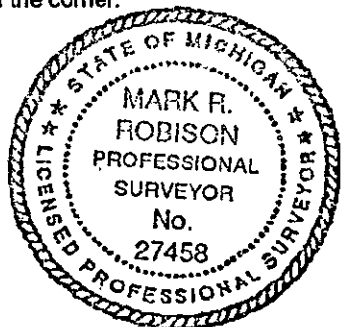

Signed by Mark R. Robison
Surveyor's Michigan License No. 27458

Date 12-19-96