

**SURVEY &
REMONUMENTATION**

APPROVED LAND CORNER
P.A. 345 OF 1990
MIDLAND COUNTY

APR 28 1995

LAND CORNER RECORDATION CERTIFICATE
Filing Requirement of Act 74, Mich. P.A. 1970

119

For corners in

<u>MIDLAND</u> (County)	Located In:	Corner Code #
1. Public Land Survey	T <u>14N</u> R <u>1W</u>	<u>K-3</u>
	T _____ R _____	_____
	T _____ R _____	_____
	T _____ R _____	_____
2. Property Controlling in Section	S _____ T _____ R _____	_____
	S _____ T _____ R _____	_____
3. Miscellaneous Property in Sec.	S _____ T _____ R _____	_____
	S _____ T _____ R _____	_____
4. Lot No. _____, Recorded Plat _____		
5. Private Claims _____		

STATE OF MICHIGAN
MIDLAND COUNTY
REMONUMENTATION & FILED

11 OCT 94 4:10 P.M.

BEVERLY J THAYER
REGISTER OF DEEDS
Register of Deeds Stamp & File Number

	A	B	C	D	E	F	G	H	I	J	K	L	M
2	6		5		4		3		2		1		
3													
4	7		8		9		10		11		12		
5													
6	18		17		16		15		14		13		
7													
8	19		20		21		22		23		24		
9													
10	30		29		28		27		26		25		
11													
12	31		32		33		34		35		36		
13													

I, PAUL B. LAPHAM, in a field survey on JULY, 19 94, do hereby certify that under requirements of P.A. 74, Michigan P.A. of 1970, the corner points mentioned in lines 1 and 2 above were in conformance with regulations and rules therefore as required in the current manual of survey instructions of the United States Department of the Interior, Bureau of Land Management or by a decree of a Court of Law and/or that the corner points mentioned in lines 3, 4 and 5 above were in conformance with the rules of the Michigan Board of Land Surveyors or by a Decree of a Court of Law; established, re-established, monumented, re-monumented, recovered, found as expressed below:

NOTE: Not more than 4 corners, all in the same town and range, may be recorded on this certificate.

A. Description of original monument and accessories and/or subsequent restoration:

K-3: Section Corner common to Sections 1, 2, 11 & 12
1852 - Austin Burt, Aspen 6" S 66°E 14 lks, Aspen 6" N 45°W 12 lks
No C.S.R.
11/29/72 - Found R.R. Spike - Paul B. Lapham & Associates Records.
(1) N 04°E, 49.49' - Pine Tree
(2) N 26°E, 42.5' - Nail & Tag in Tele. Pole
(3) S 33°30'W, 66.94' - Nail & Tag in Power Pole (M-65.94)

B. Description of corner evidence found and/or method applied in restoring or reestablishing corner:


K-3: Section Corner common to Sections 1, 2, 11 & 12
Found R.R. spike in 3/4" x 18" pipe. Excavated to 2 feet, Found 3/4" x 15" pipe and broken brown glass.
Excavated to 3 feet and found no further evidence.
Found recorded witnesses 1 & 3.

Accepted as best available evidence of the position of the original corner & replaced with Standard Monument.

Corner, K-3 was approved for remonumentation at a Peer Review Committee Meeting on 9-27, 19 94

C. Description of monument for corner and accessories established to perpetuate locating the position of the corner:

K-3: Section Corner common to Sections 1, 2, 11 & 12
Set 5/8" x 18" re-rod with brass cap stamped "Midland Co. Remon. Cor. PS 9433" in Monument Box
S 46°W, 56.25' - Nail & Tag in Light Pole
N 28°E, 75.88' - Nail & Tag in 20" Oak
N 04°E, 49.49' - Pine Tree (1)
S 33°30'W, 65.94' - Nail & Tag in Power Pole (3)

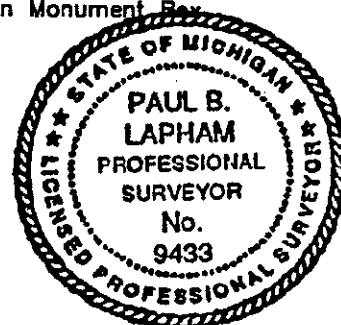

Signed by Paul B. Lapham
Surveyor's Michigan License No. 9433

Date 9-30-94