

SEQUENCE

LAND CORNER RECORDATION CERTIFICATE
Filing Requirement of Act 74, Mich. P.A. 1970

STATE OF MICHIGAN
MIDLAND COUNTY
REMONUMENTATION & FILED

For corners in

REMONUMENTATION

Located In: Corner Code #


Midland (County)

30 NOV 93 3:08 P.M.

BEVERLY J THAYER
REGISTER OF DEEDS

- 1. Public Land Survey T 14N R 1W
- 2. Property Controlling in Section S T R
- 3. Miscellaneous Property in Sec. S T R
- 4. Lot No. , Recorded Plat
- 5. Private Claims

J-5 (K-4) Seq 1

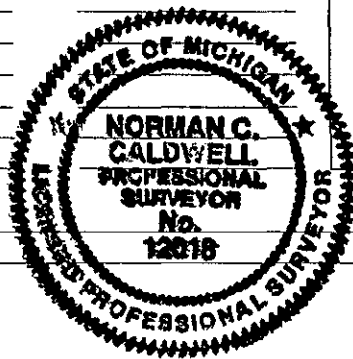

Register of Deeds Stamp & File Number

A	B	C	D	E	F	G	H	I	J	K	L	M
2	6	5	4	3	2	1						
3												
4	7	8	9	10	11	12						
5												
6	18	17	16	15	14	13						
7												
8	19	20	21	22	23	24						
9												
10	30	29	28	27	26	25						
11												
12	31	32	33	34	35	36						
13												

I, Norman C. Caldwell, in a field survey on May, 19 93, do hereby certify that under requirements of P.A. 74, Michigan P.A. of 1970, the corner points mentioned in lines 1 and 2 above were in conformance with regulations and rules therefore as required in the current manual of survey instructions of the United States Department of the Interior, Bureau of Land Management or by a decree of a Court of Law and/or that the corner points mentioned in lines 3, 4 and 5 above were in conformance with the rules of the Michigan Board of Land Surveyors or by a Decree of a Court of Law; established, re-established, monumented, re-monumented, recovered, found as expressed below:

NOTE: Not more than 4 corners, all in the same town and range, may be recorded on this certificate.

A. Description of original monument and accessories and/or subsequent restoration:

(J-5) 1/4 Cor. Sec. 11 & 14, T14N-R1W

Post Placed by Austin Burt in 1852 Subd. Resurvey N49°E 71 L.(48.66') 6" Tamarack S08°W 137 L.(90.42') 5" Tamarack

L.C.R.C. by J. Schafer, Bk. 1 P. 256, Found Conc. Mon.: North 36.25' CL M-20; N85°W 17.35' Ch'ld "x" in S. End 30" Conc. Pipe; S20°E 88.2' CL 6" Pine; S30°W 113.49' N&T in P. Pole. (Surveys in L. 4, P. 595 & L. 3, P. 594

(K-4) 1/4 Cor. Sec. 11 & 12, T14N-R1W

Post Placed by Austin Burt in 1852 Subd. Resurvey S28°E 185 L. (122.10') 8" Tamarack N15°W 206 L. (135.96') 8" Tamarack

Unrecorded references by P. Lapham, Set 1/2" Re Rod: N72°E 13.15' Hole in E. End 60" CMP; S05°E 109.3' P. Pole; N81°W 23.55' Hole in W. End 60" CMP.

Unrecorded references by Ayres, 1992, Found 1/2" Rod 1" Deep in Pav't: N60°W 47.76' N&T in End Fnc Post; S45°W 75.20' CL of 4" Pine; N10°E 76.30' N&T in M.B. Post; 4.2' S. of CL Drain to E.; 6.0' E. of Cl of Pav't. (Surveys in L. 1, P. 403, L. 2, P. 678

B. Description of corner evidence found and/or method applied in restoring or reestablishing corner:

(J-5) 1/4 Cor. Sec. 11 & 14, T14N-R1W

Found 1/2" Bar w/cap in Conc. per Bk.1 P. 256.

(K-4) 1/4 Cor. Sec. 11 & 12, T14N-R1W

Found 1/2" Iron Rod per Unrecorded References. by Ayres.

C. Description of monument for corner and accessories established to perpetuate locating the position of the corner:

(J-5) 1/4 Cor. Sec. 11 & 14, T14N-R1W

Found 1/2" Bar w/cap in conc. per Bk. 1 P.256 and is accepted as the best available evidence of the position of the original corner. S30°W 113.49' N&T in Power Pole(R) N21°W 140.72' 12" N&T #12018 in 12" J.Pine S32°E 133.06' RR spike in Power Pole N48°E 165.01' N&T #12018 in 18" Red Pine North, 37' +/- CL M-20

(K-4) 1/4 Cor. Sec. 11 & 12, T14N-R1W

Found 1/2" Iron Rod per Unrecorded Ayres & Lapham References, and is accepted as the best available evidence of the position of the original corner. Placed Mon. Box. S10°E 109.09' Power Pole(R) S45°W 75.22' 4"Red Pine(R) N65°E 42.43' 5" Aspen N70°W 43.80' 5"Willow

Signed by [Signature] Date 29 NOV 93
Surveyor's Michigan License No. 12018