

APPROVED LAND CORNER  
P.A. 345 OF 1990  
MIDLAND COUNTY

LAND CORNER RECORDATION CERTIFICATE  
Filing Requirement of Act 74, Mich. P.A. 1970

186

JBL 12/05/94  
For corners in

MIDLAND (County)	Located In:	Corner Code #
1. Public Land Survey	T 14N R 1W	K-4
	T _____ R _____	_____
	T _____ R _____	_____
	T _____ R _____	_____
2. Property Controlling in Section	S _____ T _____ R _____	_____
	S _____ T _____ R _____	_____
3. Miscellaneous Property in Sec.	S _____ T _____ R _____	_____
	S _____ T _____ R _____	_____
4. Lot No. _____, Recorded Plat _____		
5. Private Claims _____		

STATE OF MICHIGAN  
MIDLAND COUNTY  
REMONUMENTATION & FILED


21 DEC 94 11:17 A.M.

BEVERLY J THAYER  
REGISTER OF DEEDS

Register of Deeds Stamp & File Number

I, PAUL B. LAPHAM, in a field survey on OCTOBER, 19 94, do hereby certify that under requirements of P.A. 74, Michigan P.A. of 1970, the corner points mentioned in lines 1 and 2 above were in conformance with regulations and rules therefore as required in the current manual of survey instructions of the United States Department of the Interior, Bureau of Land Management or by a decree of a Court of Law and/or that the corner points mentioned in lines 3, 4 and 5 above were in conformance with the rules of the Michigan Board of Land Surveyors or by a Decree of a Court of Law; established, re-established, monumented, re-monumented, recovered, found as expressed below:

NOTE: Not more than 4 corners, all in the same town and range, may be recorded on this certificate.

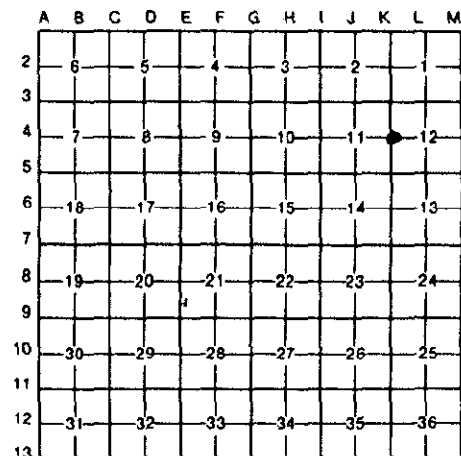

A. Description of original monument and accessories and/or subsequent restoration:

1852 AUSTIN BURT  
TAMARACK 8" S28°E 185 LKS.  
TAMARACK 8" N 15 1/2°W 206 LKS.

NO C.S.R.

7-13-73 LEONARD URBANIAK (132) LIBER 1 PGS.403-405  
SET 1/2" RE-ROD AT S.P.M.  
WIT.-(1)N72°E 13.15' HOLE IN EAST END 60" C.M.P.  
(2)S05°E 109.3' POWER POLE (GOOD)  
(3)N81°W 23.55' HOLE IN WEST END 60" C.M.P.

8-9-78 JEROME SCHAFER (132) L.2, PG.659  
FOUND 5/8" ROD & CAP IN PAVEMENT 5.2' E. OF C. OF ROAD.

5-4-92 JERRY JONES (132) L.4, PG.887  
FOUND 1/2" ROD 1" DEEP IN PAVEMENT  
WIT.-(4)N60°W NAIL & TAG IN END FENCE POST 47.76'  
(5)S45°W C 4" PINE 75.20'  
(6)N10°E NAIL & TAG IN M.B. POST 76.30'  
(7)4.2' S. OF C. OF DRAIN TO EAST  
(8)6.0' E. OF C. OF PAVEMENT

11-24-93 COLDWELL, REMON L.C.R.C. #14  
WIT.-S10°E 109.09' POWER POLE  
S45°W 75.22' 4" R. PINE  
N65°E 42.43' 5" ASPEN  
N70°W 43.80' 5" WILLOW

B. Description of corner evidence found and/or method applied in restoring or reestablishing corner:

FOUND 1/2"x18" RE-ROD IN MON. BOX EXCAVATED TO 3' DEPTH. DID NOT FIND FURTHER EVIDENCE.  
FOUND RECORDED WITNESSES 1 THROUGH 8.


Accepted as best available evidence of the position of the original corner & replaced with Standard Monument.

Corner, K-4 was approved for remonumentation at a Peer Review Committee Meeting on 12-05, 1994.

C. Description of monument for corner and accessories established to perpetuate locating the position of the corner:

K-4: 1/4 Corner common to Sections 11 & 12  
Set 5/8" x 18" re-rod with brass cap stamped "Midland Co. Cor. PS 9433" in Monument Box.

WITNESSES:  
S05°E 109.3' - NAIL & TAG - POWER POLE(2)  
N81°W 23.55' HOLE IN WEST END 60" C.M.P.(3)  
N60°W - NAIL & TAG IN END FENCE POST 47.76'(4)  
S45°W - NAIL & TAG - C 4" PINE 75.20'(5)

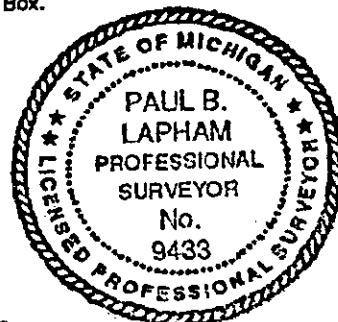

Signed by Paul B. Lapham  
Surveyor's Michigan License No. 9433

Date 12/19/94