

Seg. #1

LAND CORNER RECORDATION CERTIFICATE
Filing Requirement of Act 74, Mich. P.A. 1970

15

For corners in

Midland (County)

Located In:

REMONUMENTATION
Corner Code #


STATE OF MICHIGAN
MIDLAND COUNTY
REMONUMENTATION & FILED

30 NOV 93 3:08 P.M.

BEVERLY J THAYER
REGISTER OF DEEDS

Register of Deeds Stamp & File Number

- 1. Public Land Survey T 14N R 1W
- 2. Property Controlling in Section S T R
- 3. Miscellaneous Property in Sec. S T R
- 4. Lot No. , Recorded Plat
- 5. Private Claims

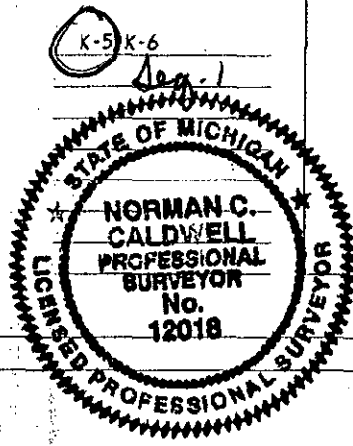

	A	B	C	D	E	F	G	H	I	J	K	L	M
2	6	5	4	3	2	1							
3													
4	7	8	9	10	11	12							
5													
6	18	17	16	15	14	13							
7													
8	19	20	21	22	23	24							
9													
10	30	29	28	27	26	25							
11													
12	31	32	33	34	35	36							
13													

I, Norman C. Caldwell, in a field survey on May, 19 93, do hereby certify that under requirements of P.A. 74, Michigan P.A. of 1970, the corner points mentioned in lines 1 and 2 above were in conformance with regulations and rules therefore as required in the current manual of survey instructions of the United States Department of the Interior, Bureau of Land Management or by a decree of a Court of Law and/or that the corner points mentioned in lines 3, 4 and 5 above were in conformance with the rules of the Michigan Board of Land Surveyors or by a Decree of a Court of Law; established, re-established, monumented, re-monumented, recovered, found as expressed below:

NOTE: Not more than 4 corners, all in the same town and range, may be recorded on this certificate.

A. Description of original monument and accessories and/or subsequent restoration:

(K-5) Sec. Cor. 11, 12, 13, & 14, T14N-R1W

Post Placed by Austin Burt in 1852 Subd. Resurvey
S38°E 86 L.(56.76') Pine
N08°W 17 L.(11.22') Pine

L.C.R.C. by D. Whittier, Recorded in Bk.1 P. 171, Found 1/2" Pipe in Mon. Box: S75°W 37.44' N&D in Lt. Pole; S75°E 37.49' N&D in T. Pole; S45°E 62.30' CL of Vert. 4" Pipe.

L.C.R.C. by P. Lapham, recorded in Bk. 1 P. 623, Found Mon. Box: S30°E 133.56' P. Pole; S30°W S30°E 86.24' P. Pole; North 36.25' CL M-20. (Surveys in L. 1, P. 403, L. 1, P. 924, L. 2, P. 678, L. 1, P. 199 & L. 1, P. 619)

(K-6) 1/4 Cor. Sec. s 13&14, T14N-R1W

Post Placed by Austin Burt in 1852 Subd. Resurvey
S47°E 121 L.(79.9') 8" Black Ash
North 446 L.(294.4') 9" Black Ash

L.C.R.C. by P. Lapham, Recorded in Bk.1 P. 104, Found 3/4" Iron Pipe: S85°E 39.2' T. Pole; N10°E 220.1' Top E. End 60" CMP; N05°W 218.8' Top W. End 60" CMP. (Surveys in L. 2, P. 330 & 339)

B. Description of corner evidence found and/or method applied in restoring or reestablishing corner:

(K-5) Sec. Cor. 11, 12, 13, & 14, T14N-R1W

Found 1/2" Pipe in Mon. Box Per Bk. 1 Pgs. 171 & 623.

(K-6) 1/4 Cor. Sec. 13 & 14, T14N-R1W

Found 3/4" Pipe per Bk.1 P. 104.

C. Description of monument for corner and accessories established to perpetuate locating the position of the corner:

(K-5) Sec. Cor. 11, 12, 13, & 14, T14N-R1W

Found 1/2" Pipe in Mon Box per Bk. 1 Pgs. 171 & 623 and is accepted as the best available evidence of the position of the original corner.

S70°W 37.59' Light Support Pole(R)
S58°E 100.54' 6" Red Pine
S30°E 108.40' 8" Black Oak
N22°E 98.53' Light Support Pole
North 35' +/- CL M-20

(K-6) 1/4 Cor. Sec. 13 & 14, T14N-R1W

Found 3/4" Pipe per Bk. 1 P. 104, Placed Mon. Box, and is accepted as the best available evidence of the position of the original cor.

S82°E 39.45' Tele. Pole (R)
S42°E 60.66' 12" Apple
S26°W 85.71' 8" Oak
West 32.90' 1" Pipe w/illegible cap

Signed by Norman C. Caldwell
Surveyor's Michigan License No. 12018

Date NOV 24, 93