

SURVEY & REMONUMENTATION

APPROVED LAND CORNER
P.A. 345 OF 1990
MIDLAND COUNTY

APR 28 1995
COMMISSION

LAND CORNER RECORDATION CERTIFICATE
Filing Requirement of Act 74, Mich. P.A. 1970

188

For corners in

MIDLAND <small>(County)</small>	Located In:	Corner Code ##
1. Public Land Survey	T <u>14N</u> R <u>1W</u>	<u>K-7</u>
	T _____ R _____	_____
	T _____ R _____	_____
	T _____ R _____	_____
2. Property Controlling in Section	S _____ T _____ R _____	_____
	S _____ T _____ R _____	_____
3. Miscellaneous Property in Sec.	S _____ T _____ R _____	_____
	S _____ T _____ R _____	_____
4. Lot No. _____, Recorded Plat _____		
5. Private Claims _____		

STATE OF MICHIGAN
MIDLAND COUNTY
REMONUMENTATION & FILED

21 DEC 94 11:18 A.M.

BEVERLY J THAYER
REGISTER OF DEEDS

Register of Deeds Stamp & File Number

	A	B	C	D	E	F	G	H	I	J	K	L
2	6	5	4	3	2							
3												
4	7	8	9	10	11							
5												
6	13	17	16	15	14							
7												
8	19	20	21	22	23							
9												
10	30	29	28	27	26							
11												
12	31	32	33	34	35							
13												

I, PAUL B. LAPHAM, in a field survey on OCTOBER, 19 94, do hereby certify that under requirements of P.A. 74, Michigan P.A. of 1970, the corner points mentioned in lines 1 and 2 above were in conformance with regulations and rules therefore as required in the current manual of survey instructions of the United States Department of the Interior, Bureau of Land Management or by a decree of a Court of Law and/or that the corner points mentioned in lines 3, 4 and 5 above were in conformance with the rules of the Michigan Board of Land Surveyors or by a Decree of a Court of Law; established, re-established, monumented, re-monumented, recovered, found as expressed below:

NOTE: Not more than 4 corners, all in the same town and range, may be recorded on this certificate.

A. Description of original monument and accessories and/or subsequent restoration:

1852 AUSTIN BURT, NO WITNESSES

1912 GIBBS
STONE-OLD CORNER IN HIGHWAY

1913 GIBBS
GASPIPE & STONE-OLD CORNER IN HIGHWAY

7-75 JEROME SCHAFER (132) L.1, PG.892
FOUND MONUMENT BOX

10-27-93 JERRY JONES (132) L.5, PG.67

FOUND T-BAR
WIT.-(1)S80°W NAIL IN POWER POLE 92.62'
(2)N88°W C OF 3" PINE 77.50'
(3)N50°E PK NAIL IN POWER POLE 89.48'
(4)S88°E PK NAIL IN POWER POLE 37.52'

B. Description of corner evidence found and/or method applied in restoring or reestablishing corner:

FOUND T-BAR IN MON. BOX BELOW THAT WAS A 1"x1" GAS PIPE. EXCAVATED TO A DEPTH OF 3'. DID NOT FIND FURTHER EVIDENCE.
FOUND RECORDED WITNESSES (1) (2) (3) & (4).


Accepted as best available evidence of the position of the original corner & replaced with Standard Monument.

Corner, K-7 was approved for remonumentation at a Peer Review Committee Meeting on 12-03, 1994.

C. Description of monument for corner and accessories established to perpetuate locating the position of the corner:

K-7: Section Corner common to Sections 13, 14, 23 & 24
Set 5/8" x 18" re-rod with brass cap stamped "Midland Co. Remon. Cor. PS 9433" in Monument Box.

WITNESSES:
S89°W - NAIL & TAG IN POWER POLE 92.62'(1)
N88°W - NAIL & TAG - C OF 3" PINE 77.50'(2)
N50°E PK NAIL IN POWER POLE 89.48'(3)
S88°E PK NAIL IN POWER POLE 37.52'(4)

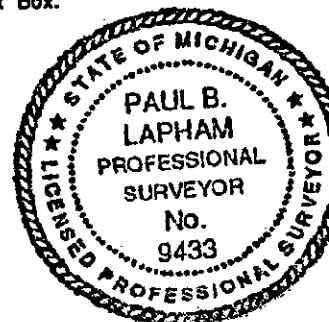

Signed by

Paul B. Lapham

Date

12/19/94

Surveyor's Michigan License No. 9433