

1000

COMMISSION

LAND CORNER RECORDATION CERTIFICATE
Filing Requirement of Act 74, Mich. P.A. 1970

17


For corners in

Midland County

Located In:

Corner Code #

- 1. Public Land Survey T 14N R 1W M-4, M-5
- T R
- T R
- T R
- 2. Property Controlling S T R
- in Section S T R
- 3. Miscellaneous S T R
- Property in Sec. S T R
- 4. Lot No. Recorded Plat
- 5. Private Claims

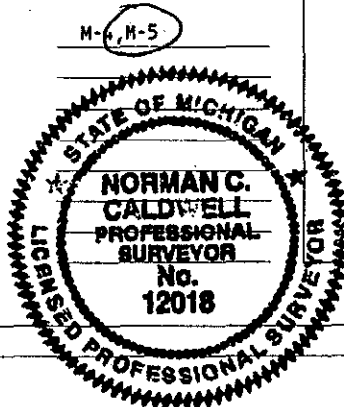

STATE OF MICHIGAN
MIDLAND COUNTY
REMONUMENTATION & FILED

30 NOV 93 3:09 P.M.

BEVERLY J THAYER
REGISTER OF DEEDS

Register of Deeds Stamp & File Number

I, Norman C. Caldwell, in a field survey on May 19 93, do hereby certify that under requirements of P.A. 74, Michigan P.A. of 1970, the corner points mentioned in lines 1 and 2 above were in conformance with regulations and rules therefore as required in the current manual of survey instructions of the United States Department of the Interior, Bureau of Land Management or by a decree of a Court of Law and/or that the corner points mentioned in lines 3, 4 and 5 above were in conformance with the rules of the Michigan Board of Land Surveyors or by a Decree of a Court of Law; established, re-established, monumented, re-monumented, recovered, found as expressed below:

| A | B | C | D | E | F | G | H | I | J | K | L | M |
|----|----|----|----|----|----|----|---|---|---|---|---|---|
| 2 | 6 | 5 | 4 | 3 | 2 | 1 | | | | | | |
| 3 | | | | | | | | | | | | |
| 4 | 7 | 8 | 9 | 10 | 11 | 12 | | | | | | |
| 5 | | | | | | | | | | | | |
| 6 | 18 | 17 | 16 | 15 | 14 | 13 | | | | | | |
| 7 | | | | | | | | | | | | |
| 8 | 19 | 20 | 21 | 22 | 23 | 24 | | | | | | |
| 9 | | | | | | | | | | | | |
| 10 | 30 | 29 | 28 | 27 | 26 | 25 | | | | | | |
| 11 | | | | | | | | | | | | |
| 12 | 31 | 32 | 33 | 34 | 35 | 36 | | | | | | |
| 13 | | | | | | | | | | | | |

NOTE: Not more than 4 corners, all in the same town and range, may be recorded on this certificate.

A. Description of original monument and accessories and/or subsequent restoration:

(M-4) Standard East 1/4 Cor, Sec. 12, T14N-R1W

Post placed by Robert Clark Jr. in 1830 Original Survey. S58°W 13 L.(8.58') 6" Maple N15°W 14 L.(9.24') 7" Willow

L.C.R.C. by M. Bennett, Recorded in Bk.1 P. 379, Found 1-1/4" Pipe in Mon. Box: S74°W 66.32' Wood Fnc. Post; S44°E 70.40' T.Pole; S72°E 68.91' 23" Oak.

Survey by J. Schafer, Recorded in L. 2 P. 761 of surveys, found 3/4" Iron in Mon. Box; S30°E 70.45' Tag in P. Pole; S55°W 66.4' Tag in Fnc Post; N25°W Nail in 8" Guard Rail. (Surveys in L. 3, P. 148)

(M-5) Standard Cor, Sec. 12 & 13, T14N-R1W

Post placed by Robert Clarke Jr in 1830 Original Survey N82°W 5 L.(3.3') 6" Tamarack S23 1/2°W 29 L.(19.14') 5" Tamarack

L.C.R.C. by M. Bennett, Recorded in Bk.1 P.380, Found 3/4" Pipe in Mon. Box: S25°E 53.49' T. Pole; N70°E 45.16' P. Pole; S75°W 33.86' Top Cen. gas Valve.

Unrecorded references by MDOT in 1959 by C. Robinson, Found 1" Pipe- 6" Deep: N70°E 73.73' 6" W. Birch; S35°E 53.23' T. Pole; S72°W 36.83' Top Cen. Gas Vent Pipe. (Surveys L. 3, P. 470, L. 2, P. 761, L. 3, P. 148, L. 4, P. 291, L. 4, P. 375)

B. Description of corner evidence found and/or method applied in restoring or reestablishing corner:

(M-4) Standard East 1/4 Cor, Sec.12, T14N-R1W

Found 1-1/4" Iron Pipe in Mon. Box per Bk. 1 P. 379 and L. 2 P. 761 of Surveys.

(M-5) Standard Cor, Sec. 12 & 13, T14N-R1W

Found 3/4" Iron Pipe in Mon. Box per Bk.1 P. 380 and Unrecorded MDOT references.

C. Description of monument for corner and accessories established to perpetuate locating the position of the corner:

(M-4) Standard East 1/4 Cor, Sec.12, T14N-R1W

Fnd 1 1/4" Iron Pipe in Mon Box per Bk. 1 P.379 & surveys rec. in L 2,P 761 and is accepted as the best available evidence of the position of the original corner.

S35°E 70.26' Power Pole(R)
S67°W 66.14' Fence Cor Post (N&W)(R)
N68°E 54.19' 7" Black Oak
N42°E 73.93' 7" Black Oak

(M-5) Standard Cor, Sec. 12 & 13, T14N-R1W

Fnd 3/4" Iron Pipe in Mon Box per Bk. 1 P. 380 and Unrecorded MDOT references, and is accepted as the best available evidence of the position of the original corner.

S75°W 33.50' Cen/Top Gas Valve(R)
S19°W 156.42' Power Pole
N18°W 160.05' Power Pole
N15°E 121.36' Tele Riser Guard Post
North 480.42' Cor. 16 & 21

Signed by *Norman C. Caldwell*

Date 24 NOV 93

Surveyor's Michigan License No. 12018