

APPROVED LAND CORNER
P.A. 345 OF 1990
MIDLAND COUNTY

12/05/94 *gag*

LAND CORNER RECORDATION CERTIFICATE
Filing Requirement of Act 74, Mich. P.A. 1970

For corners in

MIDLAND (County)	Located In:	Corner Code #
1. Public Land Survey	T 14N R 1W	K-6
	T _____ R _____	_____
	T _____ R _____	_____
	T _____ R _____	_____
2. Property Controlling in Section	S _____ T _____ R _____	_____
	S _____ T _____ R _____	_____
3. Miscellaneous Property in Sec.	S _____ T _____ R _____	_____
	S _____ T _____ R _____	_____
4. Lot No. _____, Recorded Plat _____		
5. Private Claims _____		

187

STATE OF MICHIGAN
MIDLAND COUNTY
REMONUMENTATION & FILED

21 DEC 94 11:18 A.M.

BEVERLY J THAYER
REGISTER OF DEEDS

Register of Deeds Stamp & File Number

I, PAUL B. LAPHAM, in a field survey on OCTOBER, 19 94, do hereby certify that under requirements of P.A. 74, Michigan P.A. of 1970, the corner points mentioned in lines 1 and 2 above were in conformance with regulations and rules therefore as required in the current manual of survey instructions of the United States Department of the Interior, Bureau of Land Management or by a decree of a Court of Law and/or that the corner points mentioned in lines 3, 4 and 5 above were in conformance with the rules of the Michigan Board of Land Surveyors or by a Decree of a Court of Law; established, re-established, monumented, re-monumented, recovered, found as expressed below:

NOTE: Not more than 4 corners, all in the same town and range, may be recorded on this certificate.

A. Description of original monument and accessories and/or subsequent restoration:

1852 AUSTIN BURT
WIT.-B. ASH 8" S47 1/2°E 121 LKS.
WIT.-B. ASH 9" NORTH 4.46 LKS.

5-22-71 LAPHAM, L.C.R.C. #104
FOUND 3/4" IRON PIPE
WIT.- 1, 2 & 3 ABOVE

10-27-93 JERRY JONES (132) L.5, PG.67
FOUND 1/2" PIPE IN MON. BOX
WIT.-(1)EAST NAIL IN T.P. 39.45'
(4)S40°E NAIL IN 10" APPLE 60.67'
(7)S88°W NAIL IN 8" POPLAR 46.30'
(6)S15°W NAIL IN 8" OAK 85.55'

1912 GIBBS
SET 3/4"x3' CORRUGATED STEEL BAR
AT AVERAGE DIST. ON TRAVERSE LINE

3-9-77 JEROME SCHAFER, (132) L.2, PG.350
3/4" PIPE IN MON. BOX
WIT.-(1)E. TAC IN T.P. 39.44'
(4)S45°E TAC IN 8" APPLE 60.30'
(5)N50°W NAIL IN 10" POPULAR 47.25'

11-24-93 CALDWELL, L.C.R.C. #15
FOUND 3/4" PIPE
WIT.-S82°E 39.45' TELE. POLE(1)
S42°E 60.66' 12" APPLE
S26°W 85.71' 8" OAK
WEST 32.90' 1" PIPE

1913 GIBBS
FOUND BAR

7-18-77 SCHAFER REF. L.C.R.C. # 104
(132) L.2, PG.330 & 339

4-3-71 PAUL LAPHAM (132) L.1, PG.7
WIT.-(1)S85°E 39.2' T.P.
(2)N10°E 220.1' TOP E. END 60" CMP
(3)N05°W 218.8' TOP W. END 60" CMP

B. Description of corner evidence found and/or method applied in restoring or reestablishing corner:

FOUND 3/4"x18' PIPE IN MON. BOX, EXCAVATED TO 3' DEPTH. DID NOT FIND FURTHER EVIDENCE.
FOUND RECORDED WITNESSES (1) (4) (7) & (6)

Accepted as best available evidence of the position of the original corner & replaced with Standard Monument.

Corner, K-6 was approved for remonumentation at a Peer Review Committee Meeting on 12-05, 1994.


C. Description of monument for corner and accessories established to perpetuate locating the position of the corner:

K-6: 1/4 CORNER COMMON TO 1/4 S 13 & 14

Set 5/8" x 18" re-rod with brass cap stamped "Midland Co. Remon. Cor. PS 9433" in Monument

WITNESSES:

EAST NAIL IN T.P. 39.45'(1)
S40°E NAIL IN 10" APPLE 60.67'(4)
S88°W NAIL IN 8" POPULAR 46.30'(7)
S15°W NAIL IN 8" OAK 85.55'(6)

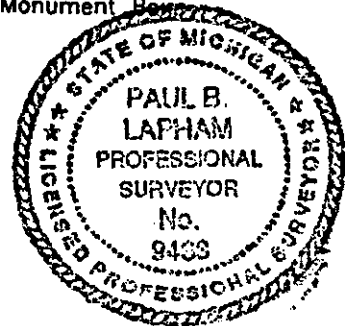

Signed by Paul B. Lapham

Date 12-19-94

Surveyor's Michigan License No. 9433