LAND CORNER RECORDATION CERTIFICATE
Filing Requirement of Act 74, Mich. P.A. 1970

For corners in

MIDLAND
(County)

	Located In:	Corner Code #/#
1. Public Land Survey	T 14N R 2W	I-9, J-9
	T ___ R ___	K-9
	T ___ R ___	
	T ___ R ___	
2. Property Controlling	S ___ T ___ R ___	
in Section	S ___ T ___ R ___	
3. Miscellaneous	S ___ T ___ R ___	
Property in Sec.	S ___ T ___ R ___	

Register of Deeds Stamp & File Number

4. Lot No. _____ , Recorded Plat _____
5. Private Claims _____

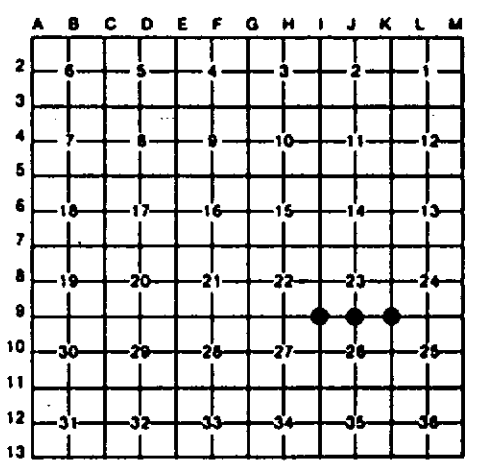

I, CARL F. ROSER, in a field survey on AUGUST 18, 19 92, do hereby certify that under requirements of P.A. 74, Michigan P.A. of 1970, the corner points mentioned in lines 1 and 2 above were in conformance with regulations and rules therefore as required in the current manual of survey instructions of the United States Department of the Interior, Bureau of Land Management or by a decree of a Court of Law and/or that the corner points mentioned in lines 3, 4 and 5 above were in conformance with the rules of the Michigan Board of Land Surveyors or by a Decree of a Court of Law; established, re-established, monumented, re-monumented, recovered, found as expressed below:

NOTE: Not more than 4 corners, all in the same town and range, may be recorded on this certificate.

A. Description of original monument and accessories and/or subsequent restoration:

I-9 J-9 K-9

B. Description of corner evidence found and/or method applied in restoring or reestablishing corner:

I-9

FD OLD LOOKING PIPE BURIED 14" FOR SW COR S-23. PIPE FITS SUB'D OF SEC 23 PER SEVERAL CERT OF SURVEYS BY RUDDELL ENG AND HUNTER, WHITTIER & ASSOC. PIPE IS IN LINE W/CTR BIT ROADLOOKING TO SOUTH AND 3' SOUTH OF CTR OF BIT RD LOOKING TO EAST.

J-9

FOUND SQUARE HEAD BOLT IN APPROX CTR E-W BIT ROAD FOR SOUTH 1/4 CORNER SEC 23.

K-9

FD PIPE IN MON BOX FOR SE COR S-23. CTR OF BIT RD W IS 3' SOUTH. CTR OF BIT RD N IS 2' E AND CTR OF GRAVEL ROAD SOUTH IS 3' EAST.

C. Description of monument for corner and accessories established to perpetuate locating the position of the corner:

I-9

FD 1 1/4' PIPE.

FACE 4" X 5' TALL PIPE (SOUTH GATE POST) N70°W 40.0'
5" MAPLE (CLP6) N30°E 38.10'
22" OAK S45°E 72.34'
6" MAPLE (CLP12) S50°W 44.16'

J-9

FD 1 1/4" SQ HEAD BOLT IN MON BOX.
#25" OAK N70°W 95.81'
#POWER POLE N05°E 39.70'
CTR E END DWY CULVERT S10°W 24.3'
#4" W BIRCH S50°W 50.72'

#WIT BY OTHERS
#RLS W. RUDDELL WIT.

K-9

FD 1/2" PIPE IN MON BOX.
#PK IN 30" CMP N45°W 38.84'
#PK IN 30" CMP N50°E 31.87'
10" W PINE S75°E 111.43'
#POWER POLE S45°W 82.87'

#WIT BY OTHERS
#RLS W. RUDDELL WIT.

STATE OF MICHIGAN
CARL F. ROSER
LAND SURVEYOR
No. 12028
REGISTERED LAND SURVEYOR

Signed by Carl F. Roser Date 3-12-93

Surveyor's Michigan License No. 12028

FORM APPROVED BY MICHIGAN STATE BOARD OF LAND SURVEYORS, JAN. 20, 1971
REVISED MAY 14, 1975
REVISED JAN., 1983