

SURVEY
RECORDATION

1893

LAND CORNER RECORDATION CERTIFICATE

Filing Requirement of Act 74, Mich. P.A. 1970

STATE OF MICHIGAN
MIDLAND COUNTY
REMONUMENTATION & FILED

For corners in

COMMISSION

REMONUMENTATION

Midland (County)

Located In:


Corner Code ##

30 NOV 93 3:09 P.M.

BEVERLY J THAYER
REGISTER OF DEEDS

- 1. Public Land Survey T^{14N} R^{2W}
- 2. Property Controlling in Section S T R
- 3. Miscellaneous Property in Sec. S T R
- 4. Lot No. , Recorded Plat
- 5. Private Claims

A-4 A-5

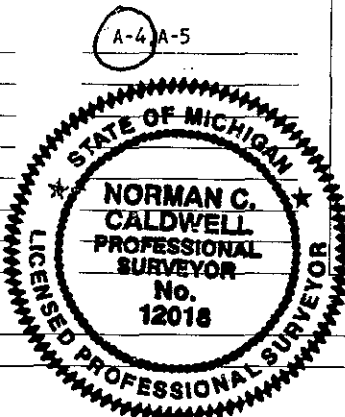

Register of Deeds Stamp & File Number

	A	B	C	D	E	F	G	H	I	J	K	L
2	6	5	4	3	2	1						
3												
4	7	8	9	10	11	12						
5												
6	18	17	16	15	14	13						
7												
8	19	20	21	22	23	24						
9												
10	30	29	28	27	26	25						
11												
12	31	32	33	34	35	36						
13												

I, Norman C. Caldwell, in a field survey on May, 1993, do hereby certify that under requirements of P.A. 74, Michigan P.A. of 1970, the corner points mentioned in lines 1 and 2 above were in conformance with regulations and rules therefore as required in the current manual of survey instructions of the United States Department of the Interior, Bureau of Land Management or by a decree of a Court of Law and/or that the corner points mentioned in lines 3, 4 and 5 above were in conformance with the rules of the Michigan Board of Land Surveyors or by a Decree of a Court of Law; established, re-established, monumented, re-monumented, recovered, found as expressed below:

NOTE: Not more than 4 corners, all in the same town and range, may be recorded on this certificate.

A. Description of original monument and accessories and/or subsequent restoration:

(A-4) Closing West 1/4 Cor, Sec.7, T14N-R2W

This position not established by original government survey

L.C.R.C. by J. Jones, Recorded in Bk. 1 P. 448, Isabella Co.
Found 20mm Rod:
SE 5.346M 76cm Maple Clump
ENE 21.534M 61cm Maple Clump
North 22.717M 61cm Maple Clump
South 28.286M (M-4)T14N-R3W per Book 1,Page 451 (Isabella County)

(A-5) Closing Cor, Sec.7 & 18, T14N-R2W

Wood Post Placed by Joel Whight 1832 Sub. of Twp.:S37°E 30 L. (6.035M) 8" (20cm) Beech; N58°E 29 L. (5.834M) 12" (30cm) Beech.

L.C.R.C. by P. Lapham, Recorded in BK. 1 P. 528
Found 26mm Pipe, Raised w/ 13mm Capped Re-rod:
N50°W 11.16M Guy Post Electric
N60°E 12.65M Conc.R/W Marker
South 21.73M (M-5)T14N-R3W
South 10.82M CL Pavm't
L.C.R.C. by H. Fluharty, Recorded in Bk. 1 P.585
Found 16mm Iron 10.796M N. of CL M-20 & on CL N-S Road: N60°E 12.50M SW cor R/W Marker; N50°W 11.131M P. Pole; N30°W 6.227M NE Cor. Conc. Culvert.
(Surveys in L. 2, P. 972, L. 3, P. 565)

B. Description of corner evidence found and/or method applied in restoring or reestablishing corner:

(A-4) Closing West 1/4 Cor, Sec.7, T14N-R2W

Found 20mm Iron Bar per Book 1 Page 448, Raised w/16mm Rebar w/cap #12018.

(A-5) Closing Cor, Sec.7 & 18, T14N-R2W

Found 13mm Iron w/illegible cap per Bk. 1, Pgs. 528 & 585. Placed Mon. Box and cap #12018.

C. Description of monument for corner and accessories established to perpetuate locating the position of the corner:

(A-4) Closing West 1/4 Cor, Sec. 7, T14N-R2W

Fnd 20mm Iron Bar per Bk.1 P.448, Raised w/16mm Rebar w/cap #12018 and is accepted as the best available evidence of the position of the original corner.

S80°E 10.631M 15cm Black Oak
N65°E 21.534M 86cm Maple Clump (R)
N16°E 22.710M 86cm Quad Maple (R)
South 28.286M (M-4)T14N-R3W per Book,Page 451 (Isabella County) (R)
N54°W 31.416M P.Pole
South 28.286M Std. Cor.

(A-5) Closing Cor, Sec.7 & 18, T14N-R2W

Fnd 13mm Iron w/illegible cap per Bk.1 Pgs. 528 & 585 and is accepted as the best available evidence of the position of the original corner. Placed monument box and cap #12018.

N52°W 11.121M Light Support Pole(R)
N58°E 12.510M Conc R/W Marker(R)
South 21.717M (M-5)T14N-R3W(R)
N21°W 29.100M 20cm Triple Maple
N48°E 35.349M 20cm Aspen
N35°W 6.230M NE Cor Conc Hdwl

Signed by Norman C. Caldwell

Date 16 NOV 93

Surveyor's Michigan License No. 12018