

**SURVEY &
REMONUMENTATION**

FEB 09 2000

APPROVED LAND CORNER

P.A. 345 OF 1990
MIDLAND COUNTY

**SECTION
LAND CORNER RECORDATION CERTIFICATE**
Filing Requirement of Act 74, Mich. P.A. 1970
Midland County Remonumentation

421

9/17/99

For Corners in
Midland

(County)

Located In:

Corner Code#:

- | | | |
|---|----------------------------|-------------|
| 1. Public Land Survey | T. <u>14</u> R. <u>2W</u> | <u>A-10</u> |
| | T. _____ R. _____ | _____ |
| | T. _____ R. _____ | _____ |
| 2. Public Controlling
in Section | S. _____ T. _____ R. _____ | _____ |
| | S. _____ T. _____ R. _____ | _____ |
| 3. Miscellaneous
Property in Section | S. _____ T. _____ R. _____ | _____ |
| | S. _____ T. _____ R. _____ | _____ |
| 4. Lot No. _____, Recorded Plat _____ | | |
| 5. Private Claims _____ | | |

STATE OF MICHIGAN
MIDLAND COUNTY
RECORDED

12/7/1999 2:59:31 PM

SCOTT I. HAINES
REGISTER OF DEEDS

Register of Deeds Stamp & File Number

I, Mark R. Robison, in a field survey on 6-8-1999, do hereby certify that under requirements of P.A. 74, Michigan P.A. of 1970, the corner points mentioned in lines 1 and 2 above were in conformance with regulations and rules therefore as required in the current manual of survey instructions of the United States Department of the Interior, Bureau of Land Management or by a decree of a Court of Law and/or that the corner points mentioned in lines 3, 4 and 5 above were in conformance with the rules of the Michigan Board of Land Surveyors or by a Decree of a Court of Law, established, re-established, monumented, re-monumented, recovered, found as expressed below.

NOTE: Not more than 2 corners, all in the same town and range, may be recorded on this certificate.

	A	B	C	D	E	F	G	H	I	J	K	L	M
1													
2	6	5	4	3	2	1							
3													
4	7	8	9	10	11	12							
5													
6	18	17	16	15	14	13							
7													
8	19	20	21	22	23	24							
9													
10	30	29	28	27	26	25							
11													
12	31	32	33	34	35	36							
13													

A. Description of original monument and accessories and/or subsequent restoration: This corner not set in GLO Resurvey.

10-03-86 Ankrom, LCRC, 621

Fd. no evidence by digging set re-rod and cap
halfway on line with N.W. Cor & S.W. Cor Sec 30

S87°E 25.03 14" W. Pine
N50°E 46.71 12" W. Pine
N60° W 21.00 12" W/ Pine
S37°W 33.00 8" Poplar

2-27-95 Gray, LCRC, 771
Same as (132) 5-240

5-28-96 Robison
Fd. C.I.
N60°W 21.03 N & C in 14" stump
East 25.40 N & C in 14" stump
S45°W 32.79 N & C in 12" stump
N45°E 46.16 N & C in 16" pine
Meas. 2651.01 South to A-11

12-05-94 Gray, (132) 5-240

Fd 1/2" x 24"

rod badly bent.

Reset with bar and cap

N51°W 21.08 14" W. Pine
N89°E 25.43 18" W. Pine
N51°E 46.27 16" W. Pine
S31°W 49.40" 4" Ash

2-27-96 Fokens (132) 5-421
Fd Bar & Cap (Wit. same as (132) 5-240
Meas. 2650.85 North to A-9
48.59 N of 1/4 Cor. Sec 25

B. Description of corner evidence found and/or method applied in restoring or re-establishing corner:

Found C.I. under new asphalt pvm't 49.84 feet (Rec. 48.59) North of Std. Cor M-10, T14N, R3W. C.I. falls 2652.04 feet North of A-11 (Rec 2651.01) and 2652.04 feet South of A-9, (Rec 2650.85). Meas. North 261.03 (Rec 262.11) to S.W. Corner Survey (132) 5-421. C.I. falls 0.20' West of Std. line between M-10 & M-9 and at Mid Point between A-9 & A-11. Fd only one OBT & it does not fit C.I.

Corner A-10, T14N, R2W was approved for remonumentation at a Peer Review Committee Meeting on 9/17/99

C. Description of monument for corner and accessories established to perpetuate locating the position of the corner:


Set 3/4" Gas Pipe with Brass Cap stamped "Midland County Remon. Cor. P.S. 27458" Box. Accepted as best method of establishment of the corner.

Witnesses:

N48°E 45.50', set spike in 24" W. Pine (OBT)
S30°E 71.90', set spike in 4" Ash
S65°W 48.70', set spike in 4" Oak
N19°W 111.61', set spike in 30" W. Pine

Signed by

Surveyor's Michigan License No. 27458

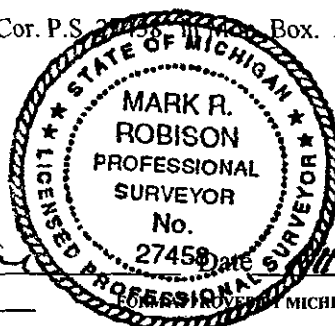

11-22-99

MICHIGAN STATE BOARD OF LAND SURVEYORS, JAN. 28, 1971