

1082
LAND CORNER RECORDATION CERTIFICATE
 Filing Requirement of Act 74, Mich. P.A. 1970

32

For corners in

<u>Midland</u>	Located In:	Corner Code ##
County		
1. Public Land Survey	T <u>14N</u> R <u>2W</u>	1-5 (1-6)
	T _____ R _____	_____
	T _____ R _____	_____
	T _____ R _____	_____
2. Property Controlling in Section	S _____ T _____ R _____	_____
	S _____ T _____ R _____	_____
3. Miscellaneous Property in Sec.	S _____ T _____ R _____	_____
	S _____ T _____ R _____	_____

STATE OF MICHIGAN
 REMONUMENTATION & FILED

30 NOV 93 3:12 P.M.

BEVERLY J THAYER
 REGISTER OF DEEDS

Register of Deeds Stamp & File Number

4. Lot No. _____, Recorded Plat _____
 5. Private Claims _____

I, Norman C. Caldwell, in a field survey on _____ May _____, 1993, do hereby certify that under requirements of P.A. 74, Michigan P.A. of 1970, the corner points mentioned in lines 1 and 2 above were in conformance with regulations and rules therefore as required in the current manual of survey instructions of the United States Department of the Interior, Bureau of Land Management or by a decree of a Court of Law and/or that the corner points mentioned in lines 3, 4 and 5 above were in conformance with the rules of the Michigan Board of Land Surveyors or by a Decree of a Court of Law; established, re-established, monumented, re-monumented, recovered, found as expressed below:

	A	B	C	D	E	F	G	H	I	J	K	L	M
2	6	5	4	3	2	1							
3													
4	7	8	9	10	11	12							
5													
6	18	17	16	15	14	13							
7													
8	19	20	21	22	23	24							
9													
10	30	29	28	27	26	25							
11													
12	31	32	33	34	35	36							
13													

NOTE: Not more than 4 corners, all in the same town and range, may be recorded on this certificate.

A. Description of original monument and accessories and/or subsequent restoration:

(1-5) Sec. Cor., 10, 11, 14, 15, T14N-R2W

(1-6) 1/4 Cor., Sec. 14 & 15, T14N-R2W

Wood Post Placed by Joel Whight in 1832 Sub. of Twp.: S67°E 28 L. (5.632M) 28" (71cm) Pine; N76°W 55 L. (11.064M) 16" (40cm) Black Ash.

Wood Post Placed by Joel Whight in 1832 Sub. of Twp.: N54°E 23 L. (4.627M) 24" (61cm) Pine; S05°W 20 L. (4.023M) 10" (25cm) Hemlock.

L.C.R.C. by D. Whittier; Recorded in Bk. 1 P. 154, 20mm Pipe 9cm below Black Top & 12.62M S. of CL M-20; SW 11.272M Utility Pole; SW 22.677M 45cm Oak; WNW 7.736M SW Cor. Conc. Headwall.

Unrecorded cor. card by C.P. Co. 1942 6.4mm x 26mm x 91cm Iron w/Broken Tile & Glass: N44°E 15.48M 12cm Elm; N27°W 20.54M 15cm Elm; S59°W 20.02M 20cm Elm. Survey by Hunter, L. 3, pg. 852

Surveys by: Jones, L. 3, pg. 407, 409, 852
 Schafer, L. 2, pg. 156
 Whittier, L. 1, pg. 150


B. Description of corner evidence found and/or method applied in restoring or reestablishing corner:

(1-5) Sec. Cor., 10, 11, 14, 15, T14N-R2W

(1-6) 1/4 Cor., Sec. 14 & 15, T14N-R2W

Found 20mm Iron Pipe bent, Replaced w/16mm Rebar in Mon. Box per witnesses in Bk.1 P. 154.

Found 13mm Iron w/Cap #19838(Jones) as an apparent replacement of unrecorded 6.5mm x 26mm x 91cm Iron, Placed mon. box

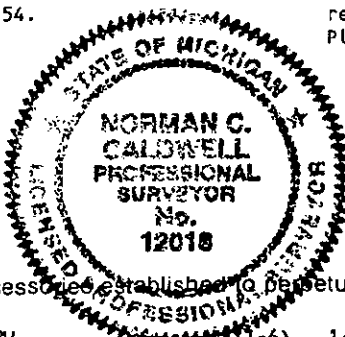

C. Description of monument for corner and accessories established to perpetuate locating the position of the corner:

(1-5) Sec. Cor., 10, 11, 14, and 15, T14N-R2W

(1-6) 1/4 Cor., Sec. 14 & 15, T14N-R2W

Found Record 20mm Iron Pipe Bent, Replaced w/16mm Rebar in Mon. Box per witnesses in Bk. 1 P.154, accepted as the best available evidence of the position of the original corner.

Found 13mm Iron w/cap #19838(Jones) as a replacement of unrecorded 6.5mm x 26mm x 91cm Iron, Placed Mon. Box and is accepted as the best available evidence of the position of the original corner.

S42°W 11.242M Light Support Pole (R)
 S32°W 22.648M 56cm White Oak (R)
 S14°E 42.475M 38cm White Oak
 N03°E 36.500M P. Pole
 North 12.677M+ C/L M-20

N45°E 20.668M 35cm Maple
 N56°E 15.100M 10cm Maple
 S72°E 18.400M 30cm Black Oak
 S42°E 22.930M 30cm Black Oak

Signed by *Norman C. Caldwell* Date 29 NOV 93
 Surveyor's Michigan License No. 12018