

APPROVED LAND CORNER
P.A. 345 OF 1990
MIDLAND COUNTY

291

2/12/96 959

LAND CORNER RECORDATION CERTIFICATE
Filing Requirement of Act 74, Mich. P.A. 1970

For corners in

<u>MIDLAND</u> (County)	Located In:	Corner Code #
1. Public Land Survey	T <u>14N</u> R <u>2W</u>	<u>1-9</u>
	T ___ R ___	_____
	T ___ R ___	_____
	T ___ R ___	_____
2. Property Controlling in Section	S ___ T ___ R ___	_____
	S ___ T ___ R ___	_____
3. Miscellaneous Property in Sec.	S ___ T ___ R ___	_____
	S ___ T ___ R ___	_____

STATE OF MICHIGAN
MIDLAND COUNTY
REMONUMENTATION & FILED

27 NOV 96 2:55 P.M.

BEVERLY J THAYER
REGISTER OF DEEDS

Register of Deeds Stamp & File Number

4. Lot No. _____, Recorded Plat _____
5. Private Claims _____

I, PAUL B. LAPHAM, in a field survey on NOVEMBER 19 95 do hereby state that under requirements of P.A. 74, Michigan P.A. of 1970, the corner points mentioned in lines 1 and 2 above were in conformance with regulations and rules therefore as required in the current manual of survey instructions of the United States Department of the Interior, Bureau of Land Management or by a decree of a Court of Law and/or that the corner points mentioned in lines 3, 4 and 5 above were in conformance with the rules of the Michigan Board of Land Surveyors or by a Decree of a Court of Law, established, re-established, monumented, recovered, found as expressed below:

NOTE: Not more than 2 corners, all in the same town and range, may be recorded on this certificate.

	A	B	C	D	E	F	G	H	I	J	K	L	M
1													
2	6		5		4		3		2		1		
3													
4	7		8		9		10		11		12		
5													
6	18		17		16		15		14		13		
7													
8	19		20		21		22		23		24		
9													
10	30		29		28		27		26		25		
11													
12	31		32		33		34		35		36		
13													

A. Description of original monument and accessories and/or subsequent restoration:

1850 WRIGHT
SET POST
WIT.-W. BIRCH 10" S39°E 25 LKS.
PINE 14" N24°W 21 LKS.

NO DATE GIBBS, C.S.R.
SET TAMARACK POST IN PLACE OF OLD CORNER
39.83' TO I-10

3-12-93 ROSER, L.C.R.C. 745
FOUND OLD LOOKING PIPE (1 1/4")
FIT SEVERAL CERTIFIED SURVEYS AND
SUBDIVISION OF SECTION

B. Description of corner evidence found and/or method applied in restoring or reestablishing corner:

DID NOT FIND ANY RECORDED SURVEYS IN MIDLAND CO. RECORDS. FOUND 1 1/4" PIPE AND OLD WITNESSES. MEAS. 2634.54' SOUTH TO I-10 (CSR 2628.78') TOP OF PIPE IS 1.3' BELOW GROUND-DROVE 3/4" PIPE INTO 1 1/4" PIPE. CORNER FALLS OFF ASPHALT, ON CENTER-LINE TO SOUTH AND 3 FEET SOUTH OF CENTERLINE TO THE EAST.


Corner, 1-9 was approved for remonumentation at a Peer Review Committee Meeting on SEP. 12, 1996

C. Description of monument for corner and accessories established to perpetuate locating the position of the corner:

SET 3/4"x18" GAS PIPE (IN 1 1/4" PIPE 15" BELOW GRADE) WITH BRASS CAP STAMPED "MIDLAND CO. REMON. COR. P.S. 9433". ACCEPTED AS BEST AVAILABLE EVIDENCE OF THE ACCEPTED POSITION OF THE CORNER.

WITNESSES:

S47°E, 72.34' - NAIL & TAG IN 23" OAK (OBT)
S50°W, 44.20' - NAIL & TAG IN 7" MAPLE (OBT)
N45°E, 62.66' - NAIL & TAG IN 18" RED OAK
N54°W, 75.26' - NAIL & TAG IN 7" TWIN MAPLE

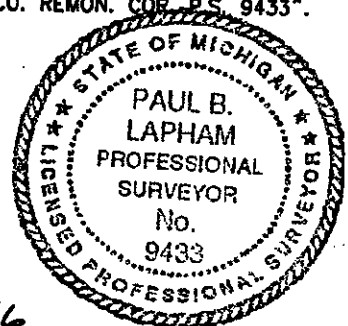

Signed by Paul B. Lapham
Surveyor's Michigan License No. 9433

Date 10-09-96