

FEB 25 2000

423

APPROVED LAND CORNER SECTION
P.A. 345 OF 1990 LAND CORNER RECORDATION CERTIFICATE
MIDLAND COUNTY Filing Requirement of Act 74, Mich. P.A. 1970
Midland County Remonumentation

STATE OF MICHIGAN
MIDLAND COUNTY
RECORDED

12/7/1999 2:59:31 PM

SCOTT I. HAINES
REGISTER OF DEEDS

9/17/99 JRG

For Corners in
Midland
(County)

Located In: Corner Code#:

1. Public Land Survey T. 14 R. 2W M-6 ✓
T. 14 R. 1W A-6
T. _____ R. _____
2. Public Controlling S. _____ T. _____ R. _____
in Section S. _____ T. _____ R. _____
3. Miscellaneous S. _____ T. _____ R. _____
Property in Section S. _____ T. _____ R. _____
4. Lot No. _____, Recorded Plat _____
5. Private Claims _____

Register of Deeds Stamp & File Number

I, Mark R. Robison, in a field survey on 6-7-1999, do hereby certify that under requirements of P.A. 74, Michigan P.A. of 1970, the corner points mentioned in lines 1 and 2 above were in conformance with regulations and rules therefore as required in the current manual of survey instructions of the United States Department of the Interior, Bureau of Land Management or by a decree of a Court of Law and/or that the corner points mentioned in lines 3, 4 and 5 above were in conformance with the rules of the Michigan Board of Land Surveyors or by a Decree of a Court of Law, established, re-established, monumented, re-monumented, recovered, found as expressed below.

	A	B	C	D	E	F	G	H	I	J	K	L	M
1													
2	6		5		4		3		2		1		
3													
4	7		8		9		10		11		12		
5													
6	18		17		16		15		14		13		
7													
8	19		20		21		22		23		24		
9													
10	30		29		28		27		26		25		
11													
12	31		32		33		34		35		36		
13													

NOTE: Not more than 2 corners, all in the same town and range, may be recorded on this certificate.

A. Description of original monument and accessories and/or subsequent restoration:

1830 Clark 1974 Lapham, LCRC, 330
1/4 Sec Post Fd. R.L.S. Cap
Oak 17, S48W 9 East 28.47 Steel Post
Elm 16, N2W 31 S45W 57.0 3" Pine
West 33.50 4" Y. Pine

1852 Burt Schafer, (132) 1-230
Not set in GLO Resurvey Fd 1/4 Cor on W. Line Sec 18
but Section Cors. are common (No Witnesses)

1985 Fluharty, LCRC, 602
Fd 3/8" re-rod w/cap 3" deep on
C.L. Rd & 2' S of Fence to E

1910 Gibbs, C.S.R. 1985 Fluharty, (132) 3-730
Set W. Oak Post Fd 3/8" re-rod w/cap
at average dist. on true line S45W 72.06 6" R. Pine
(Meas. 80.20) West 33.44 7" R. Pine
East 56.24 P.P.

B. Description of corner evidence found and/or method applied in restoring or re-establishing corner:

Found 1" x 24" pipe with cap in top, rusted off at bottom in Mon Box. Found two 1974 witnesses and three 1985 witnesses. Meas. South 2645.91 to M-7/A-7, turned angle of 180° 25' right and measured North 2644.52 to M-5/A-5.


Corner M-6, T14N, R2W and A-6 T14N, R1W were approved for remonumentation at a Peer Review Committee Meeting on 9/17/99

C. Description of monument for corner and accessories established to perpetuate locating the position of the corner:

Set 3/4" x 18" Gas Pipe with Brass Cap stamped "Midland County Remon. Cor. P.S. 27458" in Mon. Box. Accepted as best available evidence of the accepted position of the corner.

Witnesses:
S87°W 33.23', set spike in 10" Pine (OBT)
S36°W 72.00', Fd nail & tag in 10" Pine (OBT)
N35°E 62.64', Fd nail & tag in 8" J. Pine
N86°E 56.21', Fd nail & tag in P.P. (OBT)

Signed by Mark R. Robison
Surveyor's Michigan License No. 27458

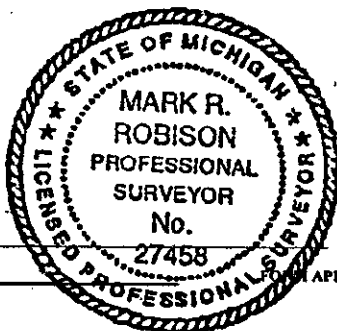

Date 11-22-99