

APPROVED LAND CORNER  
P.A. 345 OF 1990 LAND CORNER RECORDATION CERTIFICATE  
MIDLAND COUNTY Filing Requirement of Act 74, Mich. P.A. 1970  
Midland County Remonumentation

426

STATE OF MICHIGAN  
MIDLAND COUNTY  
RECORDED

12/7/1999 2:59:31 PM

SCOTT I. HAINES  
REGISTER OF DEEDS

9/17/99  
For Corners in  
Midland  
(County)

	Located In:	Corner Code#:
1. Public Land Survey	T. <u>14</u> R. <u>2W</u>	<u>M-9</u>
	T. <u>14</u> R. <u>1W</u>	<u>A-9</u>
	T. _____ R. _____	_____
2. Public Controlling in Section	S. _____ T. _____ R. _____	_____
	S. _____ T. _____ R. _____	_____
3. Miscellaneous Property in Section	S. _____ T. _____ R. _____	_____
	S. _____ T. _____ R. _____	_____
4. Lot No. _____, Recorded Plat _____		
5. Private Claims _____		

Register of Deeds Stamp & File Number

I, Mark R. Robison, in a field survey on 6-28-1999, do hereby certify that under requirements of P.A. 74, Michigan P.A. of 1970, the corner points mentioned in lines 1 and 2 above were in conformance with regulations and rules therefore as required in the current manual of survey instructions of the United States Department of the Interior, Bureau of Land Management or by a decree of a Court of Law and/or that the corner points mentioned in lines 3, 4 and 5 above were in conformance with the rules of the Michigan Board of Land Surveyors or by a Decree of a Court of Law, established, re-established, monumented, re-monumented, recovered, found as expressed below.

	A	B	C	D	E	F	G	H	I	J	K	L	M
1													
2	6	5	4	3	2	1							
3													
4	7	8	9	10	11	12							
5													
6	18	17	16	15	14	13							
7													
8	19	20	21	22	23	24							
9													
10	30	29	28	27	26	25							
11													
12	31	32	33	34	35	36							
13													

NOTE: Not more than 2 corners, all in the same town and range, may be recorded on this certificate.

A. Description of original monument and accessories and/or subsequent restoration:

- |   |   |
|---|---|
| 1830 Clark<br>Cor Sec's 24 & 25<br>W. Ash 6, N 21 W 12<br>Maple 6, S 45 W 4                                                                               | 1978 Fluharty, LCRC, 455<br>Set 5/8" x 18" re-rod in wooded area<br>(Note on LCRC says this is wrong<br>three witnesses same as 1st 3 in LCRC 465) |
| 1852 Burt<br>Int. W. Bdg. 37 links S of the Cor.<br>Sec 24 & 25, S 89° 43' E corrected<br>between Sec 19 & 30<br>Maple 6, S65E 14<br>W. Pine 14, N39 E 38 | 1978 Lapham, LCRC, 465<br>Fd 5/8" capped rod<br>N33E 15.78 3" Maple<br>S65W 31.12 Twin Oak<br>S55E 21.69 10" Oak<br>S10E 7.95 4" Maple in clump    |

SURVEY &  
REMONUMENTATION

FEB 25 2000

SECTION

- 1910 Gibbs, C.S.R.  
Set Post. Old Pine 14" N39E 38
- 1920 Gibbs, C.S.R.  
Fd oak post in survey of Sec 25, 1910
- 1923 Gibbs, C.S.R.  
Old Cor. Post standing

B. Description of corner evidence found and/or method applied in restoring or re-establishing corner:

Found 1" pipe 2640.33 South of M-8/A-8 and at a deflection angle of 0° 12' left of M-7 to M-8 extended South. M-7 to M-8 Meas. 2639.60. Found four 1978 witnesses.


Corner M-9, T14N, R2W and A-9 T14N, R1W were approved for remonumentation at a Peer Review Committee Meeting on 9/17/99

C. Description of monument for corner and accessories established to perpetuate locating the position of the corner:

Set Std. Midland County Remon Cap marked, P.S. 27458 on existing 1" pipe. Placed Mon. Box at corner. Accepted as best available evidence of the accepted position of the corner.

- Witnesses:  
S80°W 30.90', set spike in North 12" Twin Oak (OBT)  
S40°E 21.73', set spike in 18" Oak (OBT)  
N55°E 11.55', set spike in 8" Oak  
N40°W 25.55', set spike in 6" Maple

Signed by Mark R. Robison  
Surveyor's Michigan License No. 27458

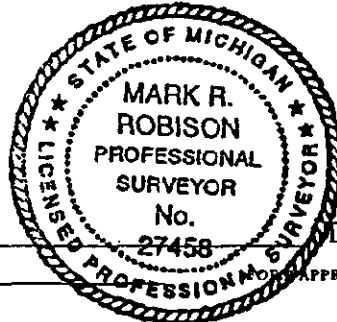

Date 11-22-99

APPROVED BY MICHIGAN STATE BOARD OF LAND SURVEYORS, JAN. 28, 1971