LAND CORNER RECORDATION CERTIFICATE

Filing Requirement of Act 74, Mich. P.A. 1970

For corners in
MIDLAND
(County)

	Located In:	Corner Code ##
1. Public Land Survey	T 15N R 01W	G-11,H-11
	T ____ R ____	
	T ____ R ____	
	T ____ R ____	
2. Property Controlling	S 27 T ____ R ____	15
in Section	S ____ T ____ R ____	
3. Miscellaneous	S ____ T ____ R ____	
Property in Sec.	S ____ T ____ R ____	

Register of Deeds Stamp & File Number

4. Lot No. _____ , Recorded Plat _____
5. Private Claims _____

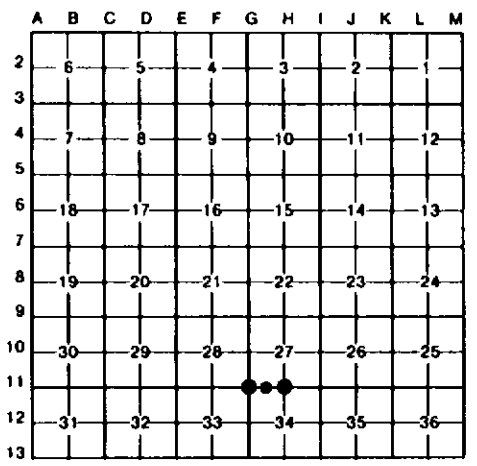

I, CARL KIISKILA , in a field survey on MAY 21 , 19 96 , do hereby certify that under requirements of P.A. 74, Michigan P.A. of 1970, the corner points mentioned in lines 1 and 2 above were in conformance with regulations and rules therefore as required in the current manual of survey instructions of the United States Department of the Interior, Bureau of Land Management or by a decree of a Court of Law and/or that the corner points mentioned in lines 3, 4 and 5 above were in conformance with the rules of the Michigan Board of Land Surveyors or by a Decree of a Court of Law; established, re-established, monumented, re-monumented, recovered, found as expressed below:

NOTE: Not more than 4 corners, all in the same town and range, may be recorded on this certificate.

A. Description of original monument and accessories and/or subsequent restoration:

G-11	H-11	15
(NO EVIDENCE OF G.L.O. CORNER, B.T'S, LINE TREES & TOPOGRAPHY, AS CALLED OUT IN THE G.L.O. LINE NOTES; UNLESS NOTED IN ITEM "B" BELOW.)		

B. Description of corner evidence found and/or method applied in restoring or reestablishing corner:

G-11	H-11	15
FOUND 2 3/8" DIAMETER BRASS CAP STAMPED "MIDLAND CO. REMON PS 9433" FOR THE SW COR OF SEC 27, MON IS 3" DEEP IN MON BOX. BLACK TOP ROAD INTERSECTION (N-G-E-W) IS 1 1/2' EAST AND 1' SOUTH. COR FITS CERT OF SURVEY BY D. LEDY (LIBER 4, PAGE 159 & LIBER 4, PAGE 967) IN THE NE1/4 OF THE SE1/4 OF SEC 28.	FOUND 3/4" PIPE W/BATTERED PS CAP FOR S1/4 COR SEC 27. FOUND A 3/4" PIPE, W/PS J. JONES #19838 CAP, SOUTH 32.86'. CTR OF E-W BLACK TOP ROAD IS 11.0' NORTH (SPLIT OF 20.6' WIDE B.TOP).	ESTABLISHED THE SW COR OF THE SE1/4 OF THE SW1/4 OF SEC 27 PER STANDARD BLM INSTRUCTION. CTR OF 20.8' WIDE E-W B.TOP RD IS 5' NORTH. CTR OF DITCH TO NORTH IS 10'+/- EAST. COR IS IN LINE W/OLD FN REMAINS SOUTH.

C. Description of monument for corner and accessories established to perpetuate locating the position of the corner:

G-11			H-11			15		
FOUND BRASS CAP MON IN MON BOX.			FOUND 3/4" PIPE W/PS CAP. SET CARBONITE POST W/LOC			SET 5/8" X 34" REROD W/PS CAP. SET CARBONITE POST W/LOC		
*CTR 4" X 4" METAL TEL RISER			TAG	NORTH	50'	TAG	NORTH	50'
	N60°W	61.6'	*18" BLACK OAK	N50°W	74.38'	FACE 2" MAPLE IN CLUMP OF 6.		
GUY POLE	N50°E	53.69'	**10" BLACK OAK	N25°E	65.30'		N20°W	68.0'
POWER POLE	S55°E	58.95'	**POWER POLE	S65°E	61.30'	POWER POLE	S30°E	34.98'
*POWER POLE	S50°W	49.52'	*16" RED PINE	S45°W	68.76'	FD 3/4" PIPE W/PS CAP		
							SOUTH	32.95'
*= 1983 WIT BY H. GILBERT PS #22433.			*= T.MULLER PS #25861,1988 WIT **= WIT BY OTHERS			POWER POLE	S60°W	58.19'

STATE OF MICHIGAN
CARL KIISKILA
LAND SURVEYOR
No. 33981
LICENSED LAND SURVEYOR

Signed by Carl T. Kiiskila Date 6-20-96

Surveyor's Michigan License No. 33981

FORM APPROVED BY MICHIGAN STATE BOARD OF LAND SURVEYORS, JAN. 28, 1971
REVISED MAY 14, 1975
REVISED JAN., 1983