LAND CORNER RECORDATION CERTIFICATE

Filing Requirement of Act 74, Mich. P.A. 1970

For corners in
MIDLAND
(County)

	Located In:	Corner Code ##
1. Public Land Survey	T 15N R 01W	1-10, 1-11
	T ___ R ___	
	T ___ R ___	
	T ___ R ___	
2. Property Controlling	S 27 T ___ R ___	14, 16
in Section	S ___ T ___ R ___	
3. Miscellaneous	S ___ T ___ R ___	
Property in Sec.	S ___ T ___ R ___	

Register of Deeds Stamp & File Number

4. Lot No. _____ , Recorded Plat _____
5. Private Claims _____

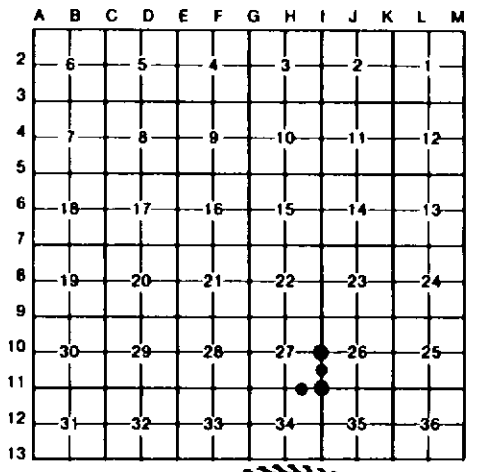

I, CARL T. KIISKILA , in a field survey on MAY 8 , 19 96 , do hereby certify that under requirements of P.A. 74, Michigan P.A. of 1970, the corner points mentioned in lines 1 and 2 above were in conformance with regulations and rules therefore as required in the current manual of survey instructions of the United States Department of the Interior, Bureau of Land Management or by a decree of a Court of Law and/or that the corner points mentioned in lines 3, 4 and 5 above were in conformance with the rules of the Michigan Board of Land Surveyors or by a Decree of a Court of Law; established, re-established, monumented, re-monumented, recovered, found as expressed below:

NOTE: Not more than 4 corners, all in the same town and range, may be recorded on this certificate.

A. Description of original monument and accessories and/or subsequent restoration:

I-10 I-11 14

(NO EVIDENCE OF G.L.O. CORNER, B.T'S, LINE TREES & TOPOGRAPHY, AS CALLED OUT IN THE G.L.O. LINE NOTES; UNLESS NOTED IN ITEM "B" BELOW.)

STATE OF MICHIGAN
CARL KIISKILA
LAND SURVEYOR
No. 33981
LICENSED LAND SURVEYOR

B. Description of corner evidence found and/or method applied in restoring or reestablishing corner:

I-10	I-11	14	16
FD 1/2" REROD IN CTR OF N-S B.TOP ROAD FOR E1/4 COR SEC. 27. IRON FITS CERT. OF SURVEYS BY LEDY ENG. AND MUELLER AND ASSOC. IN SE1/4 OF S-27.	FD 1/2" PIPE 4' NORTH OF INTER OF B.TOP RD'S N & W. TRAIL RD E & GRAVEL RD SOUTH FOR SE COR S-27. COR FITS CERT. OF SURVEYS IN AREA BY D.LEDY & D.WHITTIER (LI. 1, PG. 50).	ESTABLISHED THE NE COR OF SE1/4 OF SE1/4 OF SEC. 27 PER STANDARD BLM INSTRUCTIONS. CTR OF 20.2' WIDE N-S B.TOP ROAD IS 2.2' WEST.	ESTABLISHED THE SE COR OF SW1/4 OF SE1/4 SEC. 27 PER STANDARD BLM PROCEDURE. CTR OF 20.4' WIDE E-W B.TOP RD IS 9.4' NORTH. FOUND A 3/4" PIPE W/PS CAP #19838, J.JONES, SOUTH 32.93' (PIPE IS AT NORTH END OF NEW CHAIN LINK FENCE).

C. Description of monument for corner and accessories established to perpetuate locating the position of the corner:

I-10	I-11	14	16
FD 1/2" REROD IN CTR. OF N-S B.TOP ROAD.	FD 1/2" PIPE.	SET 5/8"X 34" REROD W/PS CAP.	SET 5/8"X 34" REROD W/PS CAP.
#POWER POLE N55°W 44.20'	#TOP CTR FIRE HYD N25°W 70.45	POWER POLE N85°W 32.05'	20"W. OAK N25°W 87.37'
#25"W.PINE N45°E 56.47'	##24"B.OAK N55°E 46.31'	TOP CTR FIRE HYD N50°E 29.87'	17"MAPLE CLP 3 N05°W 67.05'
#TOP CTR FIRE HYD N80°E 21.04'	4"MAPLE IN CLP S35°E 40.29'	20" W.OAK S75°E 30.07'	APPROX CTR OF
#4" OAK S60°W 33.82'	##POWER POLE S35°W 50.92'	17" W.PINE S55°W 36.30'	16"W.PINE N40°E 100.2'
		SET CARSONITE POST W/LOC	APPROX CTR OF
		TAG WEST 33'	2" W.PINE S15°W 33.8'
			SET CARSONITE POST W/LOC
# = P.S. T.MULLER,1988 WIT.	# = P.S. T.MULLER. 1988 WIT.		TAG NORTH 50'
	## = P.S. J.JONES, 1981 WIT.		

Signed by Carl T. Kiiskila Date 6-20-96

Surveyor's Michigan License No. 33981

FORM APPROVED BY MICHIGAN STATE BOARD OF LAND SURVEYORS, JAN. 28, 1971
REVISED MAY 14, 1975
REVISED JAN., 1983