

APPROVED LAND CORNER
P.A. 345 OF 1990
MIDLAND COUNTY

7/18/95

LAND CORNER RECORDATION CERTIFICATE
Filing Requirement of Act 74, Mich. P.A. 1970

239

For corners in

MIDLAND (County)	Located In:	Corner Code #
1. Public Land Survey	T15N R1W	C-8
	T R	
	T R	
	T R	
2. Property Controlling in Section	S T R	
	S T R	
3. Miscellaneous Property in Sec.	S T R	
	S T R	

STATE OF MICHIGAN
MIDLAND COUNTY
REMONUMENTATION & FILED
14 AUG 95 3:03 P.M.
BEVERLY J THAYER
REGISTER OF DEEDS
Register of Deeds Stamp & File Number

4. Lot No. _____, Recorded Plat _____
5. Private Claims _____

I, PAUL B. LAPHAM, in a field survey on MAY, 19 95, do hereby certify that under requirements of P.A. 74, Michigan P.A. of 1970, the corner points mentioned in lines 1 and 2 above were in conformance with regulations and rules therefore as required in the current manual of survey instructions of the United States Department of the Interior, Bureau of Land Management or by a decree of a Court of Law and/or that the corner points mentioned in lines 3, 4 and 5 above were in conformance with the rules of the Michigan Board of Land Surveyors or by a Decree of a Court of Law; established, re-established, monumented, re-monumented, recovered, found as expressed below:

	A	B	C	D	E	F	G	H	I	J	K	L	M
2	6		5		4		3		2		1		
3													
4	7		8		9		10		11		12		
5													
6	18		17		16		15		14		13		
7													
8	19		20		21		22		23		24		
9													
10	30		29		28		27		26		25		
11													
12	31		32		33		34		35		36		
13													

NOTE: Not more than 4 corners, all in the same town and range, may be recorded on this certificate.

A. Description of original monument and accessories and/or subsequent restoration:
C-8: 1/4 Corner common to Sections 19 & 20
1852 AUSTIN BURT, W. PINE 8" S52°W 13 LKS, W. PINE 24" N48°E, 28 LKS
NO C.S.R.
NO SURVEYS


WITNESS NOTE: Witnesses from above surveys and LCRC's are available in dossier file; which was presented to peer review committee and is on file at the Register of Deeds Office.

B. Description of corner evidence found and/or method applied in restoring or reestablishing corner:
C-8: 1/4 Corner common to Sections 19 & 20
No evidence of corner. Set corner on S.P.M. 2642.8' from C-7 & C-9. on line. Corner falls 7' East of Center-line at seal coat pvm't. in line with dug drain ditch to West. No occupation to East.

SURVEY &
REMONUMENTATION
NOV 1995
COMMISSION

C. Description of monument for corner and accessories established to perpetuate locating the position of the corner:

C-8: 1/4 Corner common to Sections 19 & 20
Set 5/8" x 18" re-rod with brass cap stamped "Midland Co. Remon. Cor. PS 9433" in Monument Box.
Accepted as best available evidence for the position of the corner.
N45°W 51.35' - N&T IN 12" POPLAR
S85°W 46.50' - N&T IN 8" MAPLE
S30°E 58.20' - N&T IN POWER POLE
N65°E 54.17' - N&T IN 8" OAK

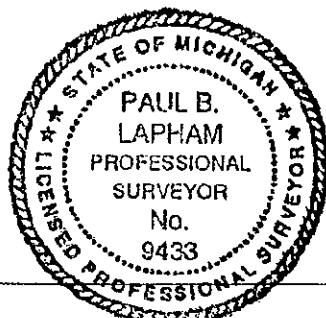

Signed by Paul B. Lapham Date 7-21-95
Surveyor's Michigan License No. 9433