

**SURVEY &
REMONUMENTATION**

PROVED LAND CORNER
P.A. 345 OF 1990
MIDLAND COUNTY

APR 28 1995

98

9/21/94

LAND CORNER RECORDATION CERTIFICATE
Filing Requirement of Act 74, Mich. P.A. 1970

or corners in


MIDLAND (County)	Located In:	Corner Code #
Public Land Survey	T <u>15N</u> R <u>1W</u>	<u>1-7</u>
	T _____ R _____	_____
	T _____ R _____	_____
	T _____ R _____	_____
Property Controlling in Section	S _____ T _____ R _____	_____
Miscellaneous Property in Sec.	S _____ T _____ R _____	_____

STATE OF MICHIGAN
MIDLAND COUNTY
FILED *P. REMON*

28 SEP 94 3:32 P.M.

BEVERLY J THAYER
REGISTER OF DEEDS
Register of Deeds Stamp & File Number

Lot No. _____, Recorded Plat _____
Private Claims _____

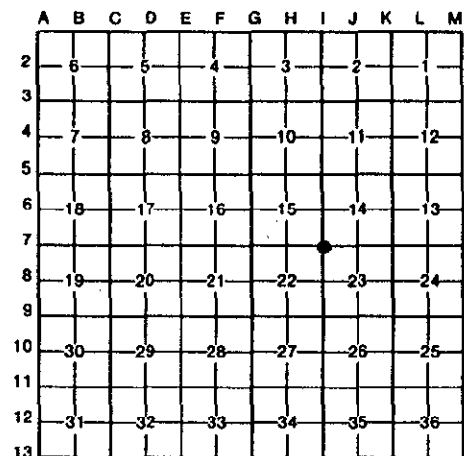

PAUL B. LAPHAM, in a field survey on JUNE, 19 94,
do hereby certify that under requirements of P.A. 74, Michigan P.A. of 1970, the corner points mentioned
in lines 1 and 2 above were in conformance with regulations and rules therefore as required in the
current manual of survey instructions of the United States Department of the Interior, Bureau of Land
Management or by a decree of a Court of Law and/or that the corner points mentioned in lines 3, 4 and 5
above were in conformance with the rules of the Michigan Board of Land Surveyors or by a Decree of a
Court of Law; established, re-established, monumented, re-monumented, recovered, found as
expressed below:

**NOTE: Not more than 4 corners, all in the same town and range, may be recorded
on this certificate.**

Description of original monument and accessories and/or subsequent restoration:

- 1-7: Corner common to Sections 14, 15, 22 and 23
1852 - Austin Burt, W. Pine 20" S 32°W, 52 lks, W. Pine 10" N 27°E, 60 lks
No C.S.R.
- 9-17-71 - John Meyers-P.B.L. (132) 1-15
1. N 20°W, 103.78' - Power Pole, 2. S 40°W, 62.25' - 8" Norway Pine
3. N 70°E, 67.40' - S.W. Cor. House, Corner is 26.06' North of R/W of U.S. Hwy 10
- 5-30-74 - Jerome Schafer Unrecorded Survey
Corner is 26.06' North of R/W of U.S. Hwy 10

Description of corner evidence found and/or method applied in restoring or reestablishing corner:


- 1-7: Corner common to Sections 14, 15, 22 and 23
Found 1" x 14" Pipe. Excavated to depth of 3 feet. Did not find further evidence.
Found Recorded Witnesses #1 & 3, as noted above.

Accepted as best available evidence of the position of the original corner & replaced with Standard Monument.

Corner 1-7 was approved for remonumentation at a Peer Review Committee Meeting on Sept. 21, 1994.

Description of monument for corner and accessories established to perpetuate locating the position of the corner:

- 1-7: Corner common to Sections 14, 15, 22 and 23
Set 5/8" x 36" re-rod with brass cap stamped "Midland Co. Remon. Cor. PS 9433" in Mon. Box
N 20°W, 103.78' - Nail & Disk in Power Pole (1)
N 70°E, 67.40' - S.W. Corner of House (3)
S 30°W, 62.40' - Nail & Disk in 12" Red Pine
S 25°E, 85.41' - Nail & Disk in Power Pole

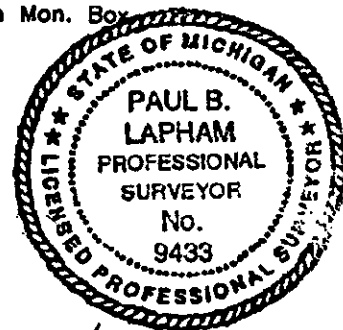

signed by Paul B. Lapham Date 9-22-94
Surveyor's Michigan License No. 9433