

APPROVED LAND CORNER
P.A. 345 OF 1990
MIDLAND COUNTY

291

LAND CORNER RECORDATION CERTIFICATE
Filing Requirement of Act 74, Mich. P.A. 1970

9/12/96 959

For corners in

MIDLAND (County)	Located In:	Corner Code #
1. Public Land Survey	T-15N R-1W	K-11
	T- R-	
	T- R-	
	T- R-	
2. Property Controlling in Section	S- T- R-	
	S- T- R-	
3. Miscellaneous Property in Sec.	S- T- R-	
	S- T- R-	

STATE OF MICHIGAN
MIDLAND COUNTY
REMONUMENTATION & FILED

27 NOV 96 2:55 P.M.

BEVERLY J THAYER
REGISTER OF DEEDS

Register of Deeds Stamp & File Number

4. Lot No. _____, Recorded Plat _____
5. Private Claims _____

I, PAUL B. LAPHAM, in a field survey on OCTOBER, 19 95 do hereby state that under requirements of P.A. 74, Michigan P.A. of 1970, the corner points mentioned in lines 1 and 2 above were in conformance with regulations and rules therefore as required in the current manual of survey instructions of the United States Department of the Interior, Bureau of Land Management or by a decree of a Court of Law and /or that the corner points mentioned in lines 3, 4 and 5 above were in conformance with the rules of the Michigan Board of Land Surveyors or by a Decree of a Court of Law; established, re-established, monumented, recovered, found as expressed below:

NOTE: Not more than 2 corners, all in the same town and range, may be recorded on this certificate.

	A	B	C	D	E	F	G	H	I	J	K	L	M
1													
2	6		5		4		3		2		1		
3													
4	7		8		9		10		11		12		
5													
6	18		17		16		15		14		13		
7													
8	19		20		21		22		23		24		
9													
10	30		29		28		27		26		25		
11													
12	31		32		33		34		35		36		
13													

- A. Description of original monument and accessories and/or subsequent restoration:
- 1852 BURT OLD CORNER
WIT.-W. PINE 8" S59°W 23 LKS.
W. PINE 9" N72°W 28 LKS.
 - NO DATE GIBBS, CSR
SET W. OAK POST 4" DIA.
OLD BEARINGS FOUND
 - 11-16-72 WHITTIER, L.C.R.C.
FOUND 3/4" SQUAREHEAD SHAFT
WIT.-N70°W, 58.80' - TAG IN POWER POLE
S70°W, 47.09' - TAG IN 12" OAK
S40°E, 20.08' - N.E. COR. CONC. HEADWALL
 - 7-18-74 H.W. ASSOC., (132) 1-259
FOUND 3/4" SQ. HD. SHAFT
WIT.-SAME AS ABOVE
 - 11-73 SCHAFER, (132) 1-474
FOUND 3/4" SQ. HD SHAFT
 - 1-2-76 LAPHAM, L.C.R.C.
FOUND 3/4" SQ. SHAFT
WIT.-SAME AS ABOVE

9-14-88 LEDY, (132) 4-338
FOUND BOAT SPIKE
3 WITNESSES

6-2-89 LEDY, (132) 4-457 & 4-460
FOUND BOAT SPIKE
WIT.-SAME AS ABOVE

12-5-90 LEDY, (132) 4-731
FOUND BOAT SPIKE
4 WITNESSES

- B. Description of corner evidence found and/or method applied in restoring or reestablishing corner:

FOUND 3/4"x14" SQUARE SHAFT ABOVE A 1 1/2"x17" PIPE FOUND OLD WITNESSES


WITNESS NOTE: WITNESSES FROM ABOVE SURVEYS AND LCRC'S ARE AVAILABLE IN DOSIER FILE; WHICH WAS PRESENTED TO PEER REVIEW COMMITTEE AND IS ON FILE AT THE REGISTER OF DEEDS OFFICE.

Corner, K-11 was approved for remonumentation at a Peer Review Committee Meeting on SEP. 12, 1996

- C. Description of monument for corner and accessories established to perpetuate locating the position of the corner:

SET 3/4"x18" GAS PIPE WITH BRASS CAP STAMPED "MIDLAND CO. REMON. COR. P.S. 9433".
ACCEPTED AS BEST AVAILABLE EVIDENCE OF THE ACCEPTED POSITION OF THE CORNER.

WITNESSES:
N70°W, 58.80' - NAIL & TAG IN POWER POLE (OBT)
N32°W, 61.60' - NAIL & TAG IN 16" RED PINE (OBT)
S25°W, 86.0' - NAIL & TAG IN 17" RED OAK
S56°W, 90.36' - NAIL & TAG IN 13" W. OAK

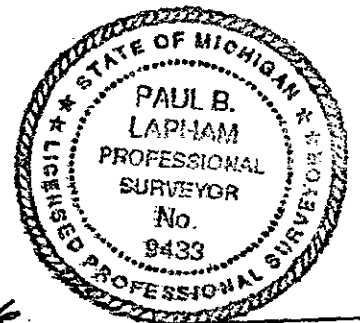

Signed by Paul B. Lapham
Surveyor's Michigan License No. 9433

Date 10-9-96