

APPROVED LAND CORNER
P.A. 345 OF 1990
MIDLAND COUNTY

292

9/13/96 gsl

LAND CORNER RECORDATION CERTIFICATE
Filing Requirement of Act 74, Mich. P.A. 1970

STATE OF MICHIGAN
MIDLAND COUNTY
REMONUMENTATION & FILED

27 NOV 96 2:55 P.M.

BEVERLY J THAYER
REGISTER OF DEEDS

For corners in

MIDLAND
(County)

Located in:

Corner Code #

1. Public Land Survey	T	15N	R	1W	K-12
	T		R		
	T		R		
	T		R		
2. Property Controlling in Section	S		T	R	
	S		T	R	
3. Miscellaneous Property in Sec.	S		T	R	
	S		T	R	

Register of Deeds Stamp & File Number

4. Lot No. _____, Recorded Plat _____
5. Private Claims _____

1	A	B	C	D	E	F	G	H	I	J	K	L	M
2	6		5		4		3		2		1		
3													
4	7		8		9		10		11		12		
5													
6	18		17		16		15		14		13		
7													
8	19		20		21		22		23		24		
9													
10	30		29		28		27		26		25		
11													
12	31		32		33		34		35		36		
13													

I, PAUL B. LAPHAM, in a field survey on OCTOBER, 19 95 do hereby state that under requirements of P.A. 74, Michigan P.A. of 1970, the corner points mentioned in lines 1 and 2 above were in conformance with regulations and rules therefore as required in the current manual of survey instructions of the United States Department of the Interior, Bureau of Land Management or by a decree of a Court of Law and for that the corner points mentioned in lines 3, 4 and 5 above were in conformance with the rules of the Michigan Board of Land Surveyors or by a Decree of a Court of Law; established, re-established, monumented, recovered, found as expressed below:

NOTE: Not more than 2 corners, all in the same town and range, may be recorded on this certificate.

A. Description of original monument and accessories and/or subsequent restoration:

1852 BURT
SET 1/4 SEC. POST
WIT.-TAMARACK 12" S49°E 33 LKS
TAMARACK 10" N38°W 17 LKS

2-4-77 SCHAFER, (132) 2-223
FOUND 1" STEEL SHAFT
WIT.-N55°W, 61.92' - NAIL & TAG IN POWER POLE
N45°E - NAIL IN POWER POLE (#9433)
S40°W, 63.38' - NAIL & TAG IN 12" OAK

8-30-90 MACDONALD
FOUND 1" IRON BAR.
WIT.-S36°W, 63.35' - NAIL IN 14" OAK
N60°E, 66.20' - N&T IN U.P.
N60°W, 61.92' - NAIL IN U.P.
N25°W, 52.76' - NAIL IN 12" PINE

1-2-76 LAPHAM, L.C.R.C.
FOUND 1 1/4" BAR
WIT.-N40°W, 36.26' - TELE. POLE
N60°E, 66.16' - POWER POLE
S85°E, 40.28' - S. END 24" CMP


2-16-77 SCHAFER, L.C.R.C.
WIT.-SAME AS 2-4-77 ABOVE
9-14-88 LEDY, (132) 4-338
FOUND 1" ROD
WIT.-SAME AS 2-16-77 ABOVE

12-5-90 LEDY
FOUND 1" ROD
WIT.-N.W., 61.42' - N&T IN P.P.
S.W., 63.38' - N&T IN 12" OAK
N.E., 65.80' - R.R. SPIKE IN P.P.
WNW, 52.74' - NAIL IN 10" RED PINE.

B. Description of corner evidence found and/or method applied in restoring or reestablishing corner:
FOUND 1 1/4"x27" IRON SHAFT. FOUND WITNESSES FROM ABOVE SURVEYS.

Corner, K-12 was approved for remonumentation at a Peer Review Committee Meeting on SEP 12, 1996
C. Description of monument for corner and accessories established to perpetuate locating the position of the corner:
SET 3/4"x18" GAS PIPE WITH BRASS CAP STAMPED "MIDLAND CO. REMON. COR. P.S. 9433".
ACCEPTED AS BEST AVAILABLE EVIDENCE OF THE ACCEPTED POSITION OF THE CORNER.

- WITNESSES:
- S40°W, 63.38' - NAIL & TAG IN 20" R. OAK (OBT)
 - N37°W, 52.90' - NAIL & TAG IN 16" R. PINE (OBT)
 - N73°W, 61.92' - NAIL & TAG IN POWER POLE (OBT)
 - N48°E, 66.16' - NAIL & TAG IN POWER POLE (OBT)

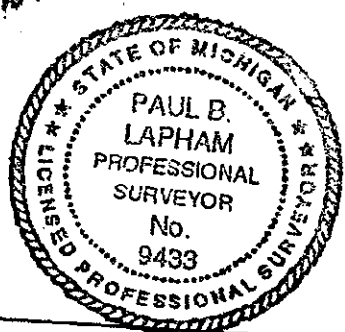

Signed by Paul B. Lapham
Surveyor's Michigan License No. 9433

Date 10-9-96