

APPROVED LAND CORNER
P.A. 345 OF 1990
MIDLAND COUNTY

293

LAND CORNER RECORDATION CERTIFICATE
Filing Requirement of Act 74, Mich. P.A. 1970

For corners in

MIDLAND	Located In:	Corner Code #
(County)		
1. Public Land Survey	T 15N R 1W	M-4
	T _____ R _____	_____
	T _____ R _____	_____
	T _____ R _____	_____
2. Property Controlling in Section	S _____ T _____ R _____	_____
	S _____ T _____ R _____	_____
3. Miscellaneous Property in Sec.	S _____ T _____ R _____	_____
	S _____ T _____ R _____	_____

STATE OF MICHIGAN
MIDLAND COUNTY
REMONUMENTATION & FILED

27 NOV 96 2:55 P.M.

BEVERLY J THAYER
REGISTER OF DEEDS

Register of Deeds Stamp & File Number

4. Lot No. _____, Recorded Plat _____
5. Private Claims _____

I, PAUL B. LAPHAM, in a field survey on OCTOBER, 19 95 do hereby state that under requirements of P.A. 74, Michigan P.A. of 1970, the corner points mentioned in lines 1 and 2 above were in conformance with regulations and rules therefore as required in the current manual of survey instructions of the United States Department of the Interior, Bureau of Land Management or by a decree of a Court of Law and /or that the corner points mentioned in lines 3, 4 and 5 above were in conformance with the rules of the Michigan Board of Land Surveyors or by a Decree of a Court of Law; established, re-established, monumented, recovered, found as expressed below:

NOTE: Not more than 2 corners, all in the same town and range, may be recorded on this certificate.

	A	B	C	D	E	F	G	H	I	J	K	L	I
1													
2	6		5		4		3		2		1		
3													
4	7		8		9		10		11		12		
5													
6	18		17		16		15		14		13		
7													
8	19		20		21		22		23		24		
9													
10	30		29		28		27		26		25		
11													
12	31		32		33		34		35		36		
13													

A. Description of original monument and accessories and/or subsequent restoration:

1831 CLARKE
1/4 SEC POST
WIT.-W. BIRCH 4" S31°W 25 LKS.
ASPEN 4" N58°W 39 LKS.

11-24-72 COURTRIGHT, L.C.R.C. 193
FOUND OLD IRON PIPE 4" DEEP, 10' WEST
OF WEST EDGE OF M-30 AS LOCATED IN
1954. M-30 REBUILT AND MON BOX SET
IN BLACK TOP.

8-17-54 MDOT, PROJECT 56-33 FIELD NOTES
FOUND 3/4" BAR (BENT)
WIT.-N80°W, 66.82' - TELE. POLE
S36°W, 108.40' - POWER POLE
S23-30E, 97.10' - POWER POLE

NO DATE MDOT, FILE # 56-R-2 R/W PLANS
CORNER 5.90' WEST OF CENTER-LINE

B. Description of corner evidence found and/or method applied in restoring or reestablishing corner:


FOUND D.N.R. MONUMENT IN MON. BOX IN PVM'T 6' WEST OF CENTERLINE M-30 AND 6' NORTH
OF CENTERLINE OF BARDEN ROAD. FOUND MDOT WITNESSES.
MEAS. NORTH 496.0' TO E-6 OF T15N, R1E.

Corner, M-4 was approved for remonumentation at a Peer Review Committee Meeting on SEP. 12, 19 96

C. Description of monument for corner and accessories established to perpetuate locating the position of the corner:

ACCEPTED D.N.R. MONUMENT IN MONUMENT BOX 5.9 FEET WEST OF CENTERLINE OF M-30. AS MIDLAND COUNTY MONUMENT.
ACCEPTED AS BEST AVAILABLE EVIDENCE OF THE ACCEPTED POSITION OF THE CORNER.

WITNESSES:
S45°E, 112.52' - NAIL & TAG IN POWER POLE
N45°E, 104.64' - NAIL & TAG IN POWER POLE
N80°W, 66.82' - NAIL & TAG IN POWER POLE (OBT)
S45°W, 108.44' - NAIL & TAG IN POWER POLE (OBT)

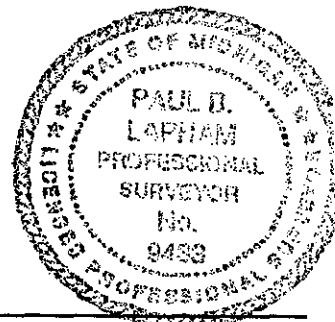

Signed by Paul B. Lapham
Surveyor's Michigan License No. 9433

Date 10-09-96