LAND CORNER RECORDATION CERTIFICATE

Filing Requirement of Act 74, Mich. P.A. 1970

For corners in
MIDLAND
(County)

	Located In:	Corner Code ##
1. Public Land Survey	T 15N R 2W	F-9,G-9
	T ___ R ___	G-10,G-11
	T ___ R ___	
	T ___ R ___	
2. Property Controlling	S ___ T ___ R ___	
in Section	S ___ T ___ R ___	
3. Miscellaneous	S ___ T ___ R ___	
Property in Sec.	S ___ T ___ R ___	

Register of Deeds Stamp & File Number

4. Lot No. _____ , Recorded Plat _____
5. Private Claims _____

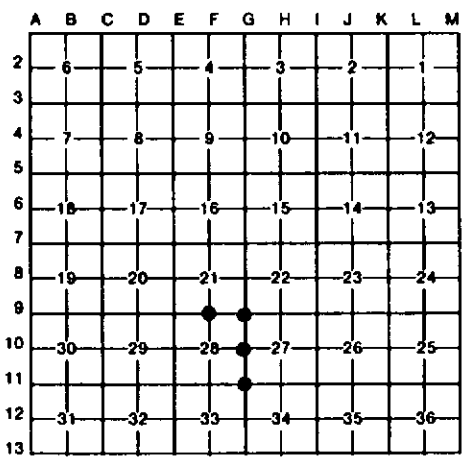

I, C.F.ROSER, in a field survey on 07-30, 19 90, do hereby certify that under requirements of P.A. 74, Michigan P.A. of 1970, the corner points mentioned in lines 1 and 2 above were in conformance with regulations and rules therefore as required in the current manual of survey instructions of the United States Department of the Interior, Bureau of Land Management or by a decree of a Court of Law and/or that the corner points mentioned in lines 3, 4 and 5 above were in conformance with the rules of the Michigan Board of Land Surveyors or by a Decree of a Court of Law; established, re-established, monumented, re-monumented, recovered, found as expressed below:

NOTE: Not more than 4 corners, all in the same town and range, may be recorded on this certificate.

~~A. Description of original monument and accessories and/or subsequent restoration:~~

F-9

G-9

G-10

G-11 (B. CONT.)
TO BE SERVED ON RESIDENT OWNERS OF LAND " (THE REC 11 CHAINS BEING PRIOR TO AS BUILT SEE MINUTES OF SURVEY & SPECIFICATIONS FOR LOCATING, ESTAB & CONSTR. OF CARROLL CREEK DRAIN).COR ALSO FITS GLO TIE'S TO BWP EDGES CLOSE CONSIDERING ACTIVE BEAVER PONDS IN AREA.

B. Description of corner evidence found and/or method applied in restoring or reestablishing corner:

F-9
ACCEPTED FD 3/4"x 3/4" T IRON FOR N1/4 COR SEC 28, AS ESTABLISHED BY RUDDELL ENGINEERING INC, 1982, IN THEIR CERT OF SURVEY OF NE1/4 OF SEC 28.

G-9
ACCEPTED FD 1 1/8" SOLID ROUND IRON FOR NW COR SEC 27. RUDDELL ENG INC USED THIS COR IN 1982 FOR THEIR SUBDIVISION OF SEC 28. FD 1" SHAFT N85°W 38.0' & FD 1 1/2"x 1 1/2" ANGLE IRON N80°W 18.5'. CTR 16'± WIDE N-S DIRT RD IS 3' W.

G-10
ACCEPTED FD 1/2" REROD FOR N1/4 COR SEC 27. THIS POSITION USED BY RUDDELL ENG INC, 1982, IN THEIR SURVEY OF SEC 28. CTR DIRT RD TO N IS 4'± E. MON IS IN LINE WITH APPROX CTR OF CROOKED TRAIL TO E.

G-11
RESTORED SE COR OF SEC 28, AT DOUBLE DISTANCE & ACROSS LINE OF NE COR & E1/4 COR OF SEC 28 (SEE RUDDELL ENGR CERT OF SURVEY OF NE1/4 OF SEC 28 AS RECORDED ON 27 JULY 1982). SEC COR AS RESTORED ABOVE FITS TIE SOUTH TO CARROLL CREEK DRAIN; 744'± SOUTH MEA, 11 CHAINS (726' TO NEAREST CHAIN) RECORD PER NOV 1912 "CITATION OF PROBATE COURT (CONT ABOVE)

C. Description of monument for corner and accessories established to perpetuate locating the position of the corner:

F-9
FD 3/4"x 3/4"x 18" T IRON, ADDED 1"X 36" GALV. PIPE.

#16"MAPLE(CLMP)	N35°W	16.05'
#12"TWN.W.BIRCH	N40°E	21.98'
#13" B.OAK	S20°E	21.59'
#15"TWN.MAPLE	S45°W	23.15'

#= L.S. W.RUDDELL WITS.

G-9
FD 1 1/8" SOLID ROUND IRON.

#13"B.OAK	N30°W	64.59'
#6"MAPLE(CLMP 6)	S30°E	39.64'
9"MAPLE(CLMP 11)	N70°E	36.91'
7"B.OAK	WEST	45.53'

SET CED POST W/LOC TAG, BESIDE FD 3/4"x 3/4" T IRON. WEST 33'

#= L.S. W.RUDDELL WIT.

G-10
FD 1/2" REROD REPLACED W/5/8"x 34" REROD W/RLS CAP.

2"MAPLE(CLMP 4)	N30 W	32.5'
1"MAPLE	N45°E	42.1'
#6"B.OAK	S70°E	44.85'
MAPLE	S35°E	44.8'

SET CED POST W/LOC TAG BESIDE FD 3/4"x3/4" T IRON. WEST 33'

#= L.S. W. RUDDELL WIT.

G-11
DROVE 1"x 4' GALV PIPE W/ALUM. DNR CAP & SET CED POST.

10"B.OAK	N75°W	48.4'
11"G.ASH	N60°E	18.9'
6"B.OAK	S10°W	15.1'
10"TW. MAPLE	S60°W	24.2'

Signed by Carl F. Roser 12-14-90 Date _____

Surveyor's Michigan License No. 12028

STATE OF MICHIGAN
CARL F. ROSER
LAND SURVEYOR
No. 12028
REGISTERED LAND SURVEYOR

FORM APPROVED BY MICHIGAN STATE BOARD OF SURVEYORS
REVISED MAR. 1975
REVISED JAN. 1983