

LAND CORNER RECORDATION CERTIFICATE
Filing Requirement of Act 74, Mich. P.A. 1970

For corners in
MIDLAND
 (County)

Located In: _____ Corner Code ≠ _____

- | | | |
|------------------------------------|-----------------------------|-----------------|
| 1. Public Land Survey | T <u>15N</u> R <u>2W</u> | <u>C-B, C-9</u> |
| | T _____ R _____ | _____ |
| | T _____ R _____ | _____ |
| | T _____ R _____ | _____ |
| 2. Property Controlling in Section | S <u>19</u> T _____ R _____ | <u>14</u> |
| | S _____ T _____ R _____ | _____ |
| 3. Miscellaneous Property in Sec. | S _____ T _____ R _____ | _____ |
| | S _____ T _____ R _____ | _____ |
4. Lot No. _____, Recorded Plat _____
5. Private Claims _____

Register of Deeds Stamp & File Number

I, C.F. ROSER, in a field survey on 11-30, 19 90, do hereby certify that under requirements of P.A. 74, Michigan P.A. of 1970, the corner points mentioned in lines 1 and 2 above were in conformance with regulations and rules therefore as required in the current manual of survey instructions of the United States Department of the Interior, Bureau of Land Management or by a decree of a Court of Law and/or that the corner points mentioned in lines 3, 4 and 5 above were in conformance with the rules of the Michigan Board of Land Surveyors or by a Decree of a Court of Law; established, re-established, monumented, re-monumented, recovered, found as expressed below:

NOTE: Not more than 4 corners, all in the same town and range, may be recorded on this certificate.

A. Description of original monument and accessories and/or subsequent restoration:


<u>C-B</u>	<u>C-9</u>	<u>14</u>
------------	------------	-----------

B. Description of corner evidence found and/or method applied in restoring or reestablishing corner:

<u>C-B</u>	<u>C-9</u>	<u>14</u>
FD AND ACCEPTED 1" x 1 1/4" IRON (BURIED 15") FOR 1/4 COR TO SEC'S 19 & 20. CORNER FALLS IN CTR OF N-S BIT SURFACE ROAD (COLEMAN RD). COR FN POST (FN'S N & E) IS 35'-E & 3'± S.	FD 1/2" REROD FOR NW COR OF SEC 29. COR FALLS IN CTR OF N-S BIT SURFACE ROAD (COLEMAN RD). CTR OF TRAIL N'LY IS 7'± SOUTH. NO FENCE'S IN THIS AREA.	ESTABLISHED NE COR OF SE 1/4 OF SE 1/4 OF SEC 19 PER STD. BLM INSTRUCTIONS. COR FALLS IN CTR OF N-S BIT SURFACE RD (COLMAN RD). NO FENCES THIS AREA.

C. Description of monument for corner and accessories established to perpetuate locating the position of the corner:

<u>C-B</u>	<u>C-9</u>	<u>14</u>
FD 1" x 1 1/4" IRON, ADDED 5/8" x 3/4" REROD W/RLS CAP.	FD 1/2" REROD. W/BATTERED RLS CAP.	DROVE 5/8" x 3/4" REROD W/RLS CAP.
2" W.PINE DUE W. 46.81'	5" R.PINE N55°E 47.44'	6" W.PINE N75°W 53.32'
COR FN POST S85°E 35.31'	6" R.PINE S70°E 42.77'	8" MAPLE (CLMP 6) N55°W 56.71'
3" W.PINE S65°E 57.38'	3" B.CHERRY (CLP 4) N70°W 84.73'	4" W.PINE N30°W 78.42'
12" TN. MAPLE S50°W 65.23'	SET CEDAR POST WITH	SET CEDAR POST WITH
SET CED POST W/LOC TAG. EAST 33'	LOC TAG. EAST 33'	LOC. TAG. WEST 33'

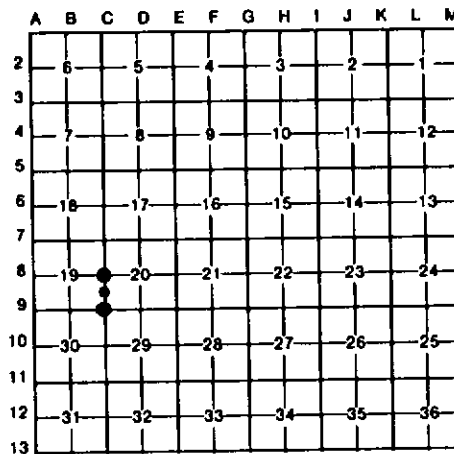

Signed by Carl F. Roser 12-14-90 Date _____
 12028

Surveyor's Michigan License No. _____

