

APPROVED LAND CORNER
P.A. 345 OF 1990
MIDLAND COUNTY

REMON. COR. C-7, GENEVA TWP.
LAND CORNER RECORDATION CERTIFICATE
Filing Requirement of Act 74, Mich. P.A. 1970

298

11/12/96

For corners in
Midland
(County)

Located in:	Corner Code #
T <u>15N</u> R <u>2W</u>	<u>C-7</u>
T ___ R ___	_____
T ___ R ___	_____
T ___ R ___	_____
S ___ T ___ R ___	_____
S ___ T ___ R ___	_____
S ___ T ___ R ___	_____
S ___ T ___ R ___	_____

STATE OF MICHIGAN
MIDLAND COUNTY
REMONUMENTATION & FILED

13 DEC 96 2:05 P.M.

BEVERLY J THAYER
REGISTER OF DEEDS

Register of Deeds Stamp & File Number

1. Public Land Survey

2. Property Controlling
in Section

3. Miscellaneous
Property in Sec.

4. Lot No. _____, Recorded Plat _____

5. Private Claims _____

I, RODNEY CLAYPOOL, in a field survey on MARCH 28, 1995, do hereby certify that under requirements of P.A. 74, Michigan P.A. of 1970, the corner points mentioned on lines 1 and 2 above were in conformance with regulations and rules therefore as required in the current manual of survey instructions of the United States Department of the interior, Bureau of Land Management or by a decree of a Court of Law and/or that the corner points mentioned in lines 3, 4 and 5 above were in conformance with the rules of the Michigan Board of Land Surveyors or by a Decree of a Court of Law; re-established, monumented, re-monumented, recovered, found as expressed below:


NOTE: Not more than 4 corners, all in the same town and range, may be recorded on this certificate.

	A	B	C	D	E	F	G	H	I	J	K	L	M
2	6	5	4	3	2	1							
3													
4	7	8	9	10	11	12							
5													
6	18	17	16	15	14	13							
7	19	20	21	22	23	24							
8													
9													
10	30	29	28	27	26	25							
11													
12	31	32	33	34	35	36							
13													

A. Description of original monument and accessories and/or subsequent restoration:

C-7 Corner common to Sections 17, 18, 19 and 20

- Survey by Government, 1830's, set post
- Survey by F. Gibbs, 1903 & 1908, post and iron with stones around
- Survey by H. Gilbert, 1977, 1978, found nail (Witnesses do not fit existing C-7)
- Survey and LCRC by T. Mueller, 1978, set 5/8" rod and cap
- Survey by H. Gilbert, 1994, found rod and cap
- Survey by R. Claypool, Road topo 1994, found 1/2" rod

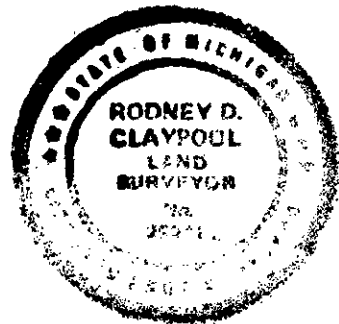

WITNESS NOTE: Witnesses from above surveys and LCRC's are available in dossier file; which was presented to peer review committee and is on file at the Register of Deeds Office.

B. Description of corner evidence found and/or method applied in restoring or reestablishing corner:

C-7 Corner common to Sections 17, 18, 19 and 20

Found 1/2" rod per surveys by F. Gibbs, T. Mueller, H. Gilbert (1994), R. Claypool, and LCRC by T. Mueller.

Corner C-7 was approved for remonumentation at a Peer Review Committee Meeting on 11/12/96.

C. Description of monument for corner and accessories established to perpetuate locating the position of the corner:

C-7 Corner common to Sections 17, 18, 19 and 20

Found 1/2" rod, replaced with 5/8" rod and brass cap stamped Midland Co. Remon Cor. PS 29241 in mon box per surveys by F. Gibbs, T. Mueller, H. Gilbert (1994), R. Claypool, and LCRC by T. Mueller; and is accepted as the best available evidence of the position of the original corner.

- S 45 Deg W, 65.34', nail and plastic disc in power pole
- N 35 Deg E, 76.99', nail and disc in power pole
- S 45 Deg E, 54.00', nail and disc in power pole
- S 50 Deg W, 92.87', nail and tag in 24" Maple

Signed by Rodney D. Claypool

Date 12-11-96

Surveyor's Michigan License No. 29241

Form approved by Michigan State Board of Land Surveyors, Jan. 28, 1971

Revised May 14, 1971

Revised Jan., 1983