

APPROVED LAND CORNER
P.A. 345 OF 1990
MIDLAND COUNTY

REMON. COR. C-8, GENEVA TWP.
LAND CORNER RECORDATION CERTIFICATE
Filing Requirement of Act 74, Mich. P.A. 1970

299

11/12/96

For corners in
Midland

(County)	Located In:	Corner Code #
1. Public Land Survey	T <u>15N</u> R <u>2W</u>	<u>C-8</u>
	T ___ R ___	_____
	T ___ R ___	_____
	T ___ R ___	_____
2. Property Controlling in Section	S ___ T ___ R ___	_____
	S ___ T ___ R ___	_____
3. Miscellaneous Property In Sec.	S ___ T ___ R ___	_____
	S ___ T ___ R ___	_____
4. Lot No. _____, Recorded Plat _____		
5. Private Claims _____		

STATE OF MICHIGAN
MIDLAND COUNTY
REMONUMENTATION & FILED

13 DEC 96 2:05 P.M.

BEVERLY J THAYER
REGISTER OF DEEDS

Register of Deeds Stamp & File Number


I, RODNEY CLAYPOOL, in a field survey on MARCH 28, 1995, do hereby certify that under requirements of P.A. 74, Michigan P.A. of 1970, the corner points mentioned on lines 1 and 2 above were in conformance with regulations and rules therefore as required in the current manual of survey instructions of the United States Department of the Interior, Bureau of Land Management or by a decree of a Court of Law and/or that the corner points mentioned in lines 3, 4 and 5 above were in conformance with the rules of the Michigan Board of Land Surveyors or by a Decree of a Court of Law; re-established, monumented, re-monumented, recovered, found as expressed below:

NOTE: Not more than 4 corners, all in the same town and range, may be recorded on this certificate.

	A	B	C	D	E	F	G	H	I	J	K	L	M
2	6	5	4	3	2	1							
3													
4	7	8	9	10	11	12							
5													
6	18	17	16	15	14	13							
7													
8	19	20	21	22	23	24							
9													
10	30	29	28	27	26	25							
11													
12	31	32	33	34	35	36							
13													

A. Description of original monument and accessories and/or subsequent restoration:

- C-8 1/4 corner common to Sections 19 and 20
- Survey by Government, 1830's, set post
 - Survey by F. Gibbs, 1908, set post
 - Survey by R. Claypool, 1994, (Road Topo) found rod and cap
 - LCRC by C. Roser, 1990, found 1" x 1 1/4" iron

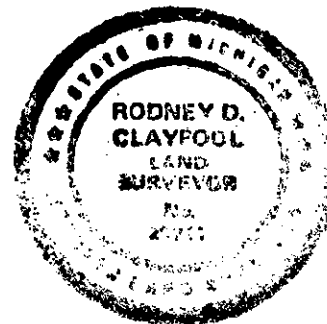

WITNESS NOTE: Witnesses from above surveys and LCRC's are available in dossier file; which was presented to peer review committee and is on file at the Register of Deeds Office.

B. Description of corner evidence found and/or method applied in restoring or reestablishing corner:

- C-8 1/4 corner common to Sections 19 and 20
- Found rod and cap per surveys by F. Gibbs, R. Claypool, and LCRC by C. Roser.

Corner C-8 was approved for remonumentation at a Peer Review Committee Meeting on 11/12/96.

C. Description of monument for corner and accessories established to perpetuate locating the position of the corner:

- C-8 1/4 corner common to Sections 19 and 20
- Found rod and cap, replaced with 5/8" rod and brass cap stamped Midland Co. Remon Cor. PS 29241 in mon box per surveys by F. Gibbs, R. Claypool, and LCRC by C. Roser; and is accepted as the best available evidence of the position of the original corner.
 - N 50 Deg E, 41.00', pk nail in large gate post
 - N 20 Deg W, 97.99', pk nail in power pole
 - S 50 Deg W, 65.10', pk nail in twin 15" Maple
 - S 50 Deg E, 57.40', pk nail in 5" Pine

Signed by Rodney D. Claypool Date 12-11-96

Surveyor's Michigan License No. 29241