

**SURVEY &
REMONUMENTATION**

**APPROVED LAND CORNER
P.A. 345 OF 1990
MIDLAND COUNTY**

OCT 03 1996

**REMON. COR. C-10, GENEVA TWP.
LAND CORNER RECORDATION CERTIFICATE
Filing Requirement of Act 74, Mich. P.A. 1970**

**COMMISSION
257**

4/23/96 *[Signature]*

For corners in
Midland
(County)

STATE OF MICHIGAN
MIDLAND COUNTY
REMONUMENTATION & FILED

22 AUG 96 8:04 A.M.

BEVERLY J THAYER
REGISTER OF DEEDS

	Located in:	Corner Code #
1. Public Land Survey	T <u>15N</u> R <u>2W</u>	<u>C-10</u>
	T ___ R ___	_____
	T ___ R ___	_____
	T ___ R ___	_____
2. Property Controlling in Section	S ___ T ___ R ___	_____
	S ___ T ___ R ___	_____
3. Miscellaneous Property in Sec.	S ___ T ___ R ___	_____
	S ___ T ___ R ___	_____
4. Lot No. _____, Recorded Plat _____		
5. Private Claims _____		

Register of Deeds Stamp & File Number

A B C D E F G H I J K L M

2	6	5	4	3	2	1
3						
4	7	8	9	10	11	12
5						
6	18	17	16	15	14	13
7						
8	19	20	21	22	23	24
9						
10	30	29	28	27	26	25
11						
12	31	32	33	34	35	36
13						

I, RODNEY CLAYPOOL, in a field survey on MARCH 28, 1995, do hereby certify that under requirements of P.A. 74, Michigan P.A. of 1970, the corner points mentioned on lines 1 and 2 above were in conformance with regulations and rules therefore as required in the current manual of survey instructions of the United States Department of the Interior, Bureau of Land Management or by a decree of a Court of Law and/or that the corner points mentioned in lines 3, 4 and 5 above were in conformance with the rules of the Michigan Board of Land Surveyors or by a Decree of a Court of Law; re-established, monumented, re-monumented, recovered, found as expressed below:

NOTE: Not more than 4 corners, all in the same town and range, may be recorded on this certificate.

A. Description of original monument and accessories and/or subsequent restoration:

C-10 1/4 corner common to Sections 29 and 30


- Survey by Government, 1830's, set post
- Survey by J. Jones, 1975, found nail and tag
- Survey by R. Claypool, (Road Topo), 1994
- LCRC by C. Roser, 1990, found 1/2" pipe

WITNESS NOTE: Witnesses from above surveys and LCRC's are available in dossier file; which was presented to peer review committee and is on file at the Register of Deeds Office.

B. Description of corner evidence found and/or method applied in restoring or reestablishing corner:

C-10 1/4 corner common to Sections 29 and 30
Found 1/2" pipe per surveys by J. Jones, R. Claypool, and LCRC by C. Roser.

Corner C-10 was approved for remonumentation at a Peer Review Committee Meeting on 4/23/96.

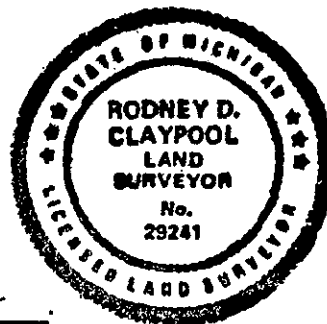

C. Description of monument for corner and accessories established to perpetuate locating the position of the corner:

C-10 1/4 corner common to Sections 29 and 30

Found 1/2" pipe, replaced with 5/8" rod and brass cap stamped Midland Co. Remon Cor. PS 29241 in mon box per surveys by J. Jones, R. Claypool, and LCRC by C. Roser; and is accepted as the best available evidence of the position of the accepted corner.

- S 60 Deg W, 66.40', pk nail in telephone pole
- S 40 Deg E, 45.08', pk nail in power pole
- S 45 Deg E, 74.97', nail in 20" Oak
- N 70 Deg E, 70.22', nail in 15" Oak

Signed by Rodney D. Claypool Date 06-24-96

Surveyor's Michigan License No. 29241