

**SURVEY &  
REMONUMENTATION**

OCT 03 1996

**APPROVED LAND CORNER  
P.A. 345 OF 1990  
MIDLAND COUNTY**

**REMON. COR. C-13, GENEVA TWP.  
LAND CORNER RECORDATION CERTIFICATE  
Filing Requirement of Act 74, Mich. P.A. 1970**

**COMMISSION  
259**

STATE OF MICHIGAN  
MIDLAND COUNTY  
REMONUMENTATION & FILED

22 AUG 96 8:04 A.M.

BEVERLY J THAYER  
REGISTER OF DEEDS

Register of Deeds Stamp & File Number

For corners in <u>Midland</u> (County)	Located in:	Corner Code #
1. Public Land Survey	T <u>15N</u> R <u>2W</u>	<u>C-13</u>
	T ___ R ___	_____
	T ___ R ___	_____
	T ___ R ___	_____
2. Property Controlling in Section	S ___ T ___ R ___	_____
	S ___ T ___ R ___	_____
3. Miscellaneous Property in Sec.	S ___ T ___ R ___	_____
	S ___ T ___ R ___	_____
4. Lot No. _____, Recorded Plat _____		
5. Private Claims _____		

	A	B	C	D	E	F	G	H	I	J	K	L	M
2	6	5	4	3	2	1							
3													
4	7	8	9	10	11	12							
5													
6	18	17	16	15	14	13							
7													
8	19	20	21	22	23	24							
9													
10	30	29	28	27	26	25							
11													
12	31	32	33	34	35	36							
13													

I, RODNEY CLAYPOOL, in a field survey on MARCH 28, 1995, do hereby certify that under requirements of P.A. 74, Michigan P.A. of 1970, the corner points mentioned on lines 1 and 2 above were in conformance with regulations and rules therefore as required in the current manual of survey instructions of the United States Department of the Interior, Bureau of Land Management or by a decree of a Court of Law and/or that the corner points mentioned in lines 3, 4 and 5 above were in conformance with the rules of the Michigan Board of Land Surveyors or by a Decree of a Court of Law; re-established, monumented, re-monumented, recovered, found as expressed below:

**NOTE: Not more than 4 corners, all in the same town and range, may be recorded on this certificate.**

**A. Description of original monument and accessories and/or subsequent restoration:**

C-13 Section corner common to Sections 31 and 32 on south townline


Survey by Government, 1830, set post  
Survey by M. Robinson, 1991, found iron  
Survey by R. Claypool, (Road Topo), 1994, found iron  
LCRC by G. Gray, 1991, set iron

WITNESS NOTE: Witnesses from above surveys and LCRC's are available in dossier file; which was presented to peer review committee and is on file at the Register of Deeds Office.

**B. Description of corner evidence found and/or method applied in restoring or reestablishing corner:**

C-13 Section corner common to Sections 31 and 32 on south townline

Found 1/2" rod per survey by M. Robinson, R. Claypool, and LCRC by G. Gray.

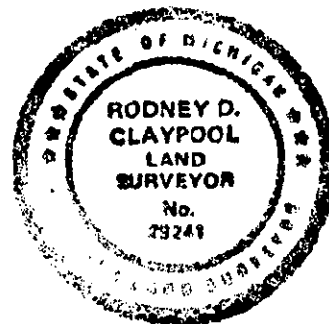

Corner C-13 was approved for remonumentation at a Peer Review Committee Meeting on 4/23/96.

**C. Description of monument for corner and accessories established to perpetuate locating the position of the corner:**

C-13 Section corner common to Sections 31 and 32 on south townline

Found 1/2" rod, replaced with 5/8" rod and brass cap stamped Midland Co. Remon Cor. PS 29241 in mon box per survey by M. Robinson, R. Claypool, and LCRC by G. Gray; and is accepted as the best available evidence of the position of the accepted corner.

S 30 Deg W, 48.66', nail and disc in power pole  
S 45 Deg E, 69.32', nail and disc in power pole  
N 50 Deg E, 100.66', nail and disc in power pole  
N 50 Deg W, 71.50', nail in 5" Poplar  
East 9.25', 1/2" rod Greendale Township corner (C-1, T14N-R2W)

Signed by Rodney D. Claypool Date 06-24-96