

APPROVED LAND CORNER
P.A. 345 OF 1990
MIDLAND COUNTY

7/18/95

LAND CORNER RECORDATION CERTIFICATE
Filing Requirement of Act 74, Mich. P.A. 1970

242

For corners in

	MIDLAND (County)	Located In:	Corner Code #
1. Public Land Survey		T15N R2W	M-6
		T _____ R _____	_____
		T _____ R _____	_____
		T _____ R _____	_____
2. Property Controlling in Section	S _____	T _____ R _____	_____
	S _____	T _____ R _____	_____
3. Miscellaneous Property in Sec.	S _____	T _____ R _____	_____
	S _____	T _____ R _____	_____

STATE OF MICHIGAN
MIDLAND COUNTY
REMONUMENTATION & FILED

14 AUG 95 3:04 P.M.

BEVERLY J THAYER
REGISTER OF DEEDS

Register of Deeds Stamp & File Number

4. Lot No. _____, Recorded Plat _____
5. Private Claims _____

	A	B	C	D	E	F	G	H	I	J	K	L	M
2	6	5	4	3	2								
3													
4	7	8	9	10	11	12							
5													
6	18	17	16	15	14	13							
7													
8	19	20	21	22	23	24							
9													
10	30	29	28	27	26	25							
11													
12	31	32	33	34	35	36							
13													

I, PAUL B. LAPHAM, in a field survey on MAY, 1995, do hereby certify that under requirements of P.A. 74, Michigan P.A. of 1970, the corner points mentioned in lines 1 and 2 above were in conformance with regulations and rules therefore as required in the current manual of survey instructions of the United States Department of the Interior, Bureau of Land Management or by a decree of a Court of Law and/or that the corner points mentioned in lines 3, 4 and 5 above were in conformance with the rules of the Michigan Board of Land Surveyors or by a Decree of a Court of Law; established, re-established, monumented, re-monumented, recovered, found as expressed below:

NOTE: Not more than 4 corners, all in the same town and range, may be recorded on this certificate.

A. Description of original monument and accessories and/or subsequent restoration:
M-6: East 1/4 Corner Section 13, CORNER COMMON TO A-6, T15N-R1W
1830 CLARK T15N, R2W, ELM 15" S1°E 37 LKS., MAPLE 17" N26°W, 32 LKS.
NO C.S.R.
4-27-90 LEDY, FOUND 1/2" ROD


WITNESS NOTE: Witnesses from above surveys and LCRC's are available in dossier file; which was presented to peer review committee and is on file at the Register of Deeds Office.

3. Description of corner evidence found and/or method applied in restoring or reestablishing corner:
M-6: East 1/4 Corner Section 13
Found 1/2" rod and witnesses per Ledy Survey at intersection of gravel roads. Measured North 2633.5' to M-5.

SURVEY &
REMONUMENTATION
MAY 1995
COMMISSION

Corner, M-6 was approved for remonumentation at a Peer Review Committee Meeting on 7-18, 1995.
Description of monument for corner and accessories established to perpetuate locating the position of the corner:

M-6: East 1/4 Corner Section 13
Set 5/8" x 18" re-rod with brass cap stamped "Midland Co. Remon. Cor. PS 9433" in gravel road
Accepted as best available evidence of the accepted position of the corner.
S42°E 43.47' - N&T IN CENTER FENCE POST
N43°E 60.66' - N&T IN 10" W. PINE
N40°W 77.27' - N&T IN POWER POLE
S77°W 41.05' - N&T IN 8" OAK

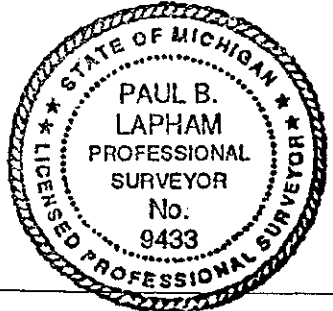

Signed by Paul B. Lapham Date 7/21/95
Surveyor's Michigan License No. 9433