

SURVEY & REMONUMENTATION

**APPROVED LAND CORNER
P.A. 345 OF 1990
MIDLAND COUNTY**

APR 28 1995

COMMISSION

11/28/94 G.P.G.

**LAND CORNER RECORDATION CERTIFICATE
Filing Requirement of Act 74, Mich. P.A. 1970**

For corners in

MIDLAND (County)	Located In:	Corner Code #
1. Public Land Survey	T <u>15N</u> R <u>1E</u>	<u>E-3</u>
	T _____ R _____	_____
	T _____ R _____	_____
	T _____ R _____	_____
2. Property Controlling in Section	S _____ T _____ R _____	_____
	S _____ T _____ R _____	_____
3. Miscellaneous Property in Sec.	S _____ T _____ R _____	_____
	S _____ T _____ R _____	_____
4. Lot No. _____, Recorded Plat _____		
5. Private Claims _____		

176


STATE OF MICHIGAN
MIDLAND COUNTY
REMONUMENTATION & FILED

21 DEC 94 11:16 A.M.

BEVERLY J THAYER
REGISTER OF DEEDS
Register of Deeds Stamp & File Number

I, PAUL B. LAPHAM, in a field survey on NOVEMBER, 19 94, do hereby certify that under requirements of P.A. 74, Michigan P.A. of 1970, the corner points mentioned in lines 1 and 2 above were in conformance with regulations and rules therefore as required in the current manual of survey instructions of the United States Department of the Interior, Bureau of Land Management or by a decree of a Court of Law and/or that the corner points mentioned in lines 3, 4 and 5 above were in conformance with the rules of the Michigan Board of Land Surveyors or by a Decree of a Court of Law; established, re-established, monumented, re-monumented, recovered, found as expressed below:

NOTE: Not more than 4 corners, all in the same town and range, may be recorded on this certificate.

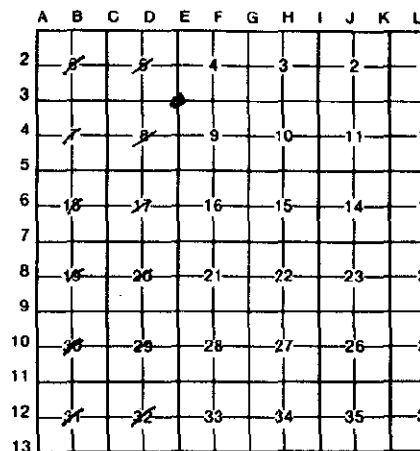

A. Description of original monument and accessories and/or subsequent restoration:

1831 HARVEY PARKE
WIT.-INT. MER. 8.67' NORTH
PINE 24" N67°E 20'
OAK 7" S67°E 22'

NO C.S.R.

8-21-67 M.S.H.D. RIGHT-OF-WAY MAPS.

8-13-93 JERRY JONES (132) SURVEY
FOUND IRON IN MON. BOX
WIT.-(1)EAST $\frac{1}{2}$ ROAD 10.7'
(2)EAST $\frac{3}{4}$ " PIPE 85.7'
(3)S65°W NAIL IN 6" ASH 44.37'
(4)N30°W NAIL IN 6" COTTONWOOD 108.25'
(5)N70°E NAIL IN 8" ASH 85.55'

B. Description of corner evidence found and/or method applied in restoring or reestablishing corner:

FOUND M.S.H.D. CAPPED IRON 8" DEEP IN MON. BOX, COULD NOT REMOVE.
FOUND WITNESSES # 1, 2, 3, 4 & 5.
MEASURED SOUTH 571.10 FEET TO M-1, T15N, R1W. (G.L.O. 572.22)


Accepted as best available evidence of the position of the original corner & replaced with Standard Monument.

Corner, E-3 was approved for remonumentation at a Peer Review Committee Meeting on Nov 28, 19 94

C. Description of monument for corner and accessories established to perpetuate locating the position of the corner:

E-3: Corner common to Sections 4 & 9
ACCEPTED M.S.H.D. BRASS MONUMENT IN MON. BOX AS SUBSTITUTE FOR STANDARD MIDLAND COUNTY MONUMENT.

WITNESSES:
EAST 85.70' $\frac{3}{4}$ " PIPE (2)
S65°W 44.37' - N&T IN 6" ASH (3)
N30°W 108.25' - N&T IN 6" COTTONWOOD (4)
N70°E 85.55' - N&T IN 8" ASH (5)

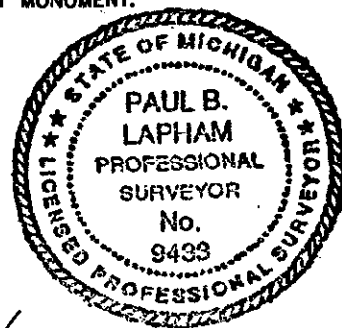

Signed by Paul B. Lapham

Date 12-19-94

Surveyor's Michigan License No. 9433