

**SURVEY &
REMONUMENTATION**

APR 28 1995

COMMISSION

**APPROVED LAND CORNER
P.A. 345 OF 1990
MIDLAND COUNTY**

11/28/94 JLP

**LAND CORNER RECORDATION CERTIFICATE
Filing Requirement of Act 74, Mich. P.A. 1970**

For corners in

| | | |
|---------------------------------------|--------------------------|---------------|
| <u>MIDLAND</u> (County) | Located In: | Corner Code # |
| 1. Public Land Survey | T <u>15N</u> R <u>1E</u> | <u>E-4</u> |
| | T _____ R _____ | _____ |
| | T _____ R _____ | _____ |
| | T _____ R _____ | _____ |
| 2. Property Controlling in Section | S _____ T _____ R _____ | _____ |
| | S _____ T _____ R _____ | _____ |
| 3. Miscellaneous Property in Sec. | S _____ T _____ R _____ | _____ |
| | S _____ T _____ R _____ | _____ |
| 4. Lot No. _____, Recorded Plat _____ | | |
| 5. Private Claims _____ | | |

177

STATE OF MICHIGAN
MIDLAND COUNTY
REMONUMENTATION & FILED

21 DEC 94 11:16 A.M.
Register of Deeds Stamp & File Number

BEVERLY J THAYER
REGISTER OF DEEDS

| | A | B | C | D | E | F | G | H | I | J | K |
|----|---|---|---|---|---|---|---|---|---|---|---|
| 2 | | | | | | | | | | | |
| 3 | | | | | | | | | | | |
I, PAUL B. LAPHAM, in a field survey on NOVEMBER, 19 94, do hereby certify that under requirements of P.A. 74, Michigan P.A. of 1970, the corner points mentioned in lines 1 and 2 above were in conformance with regulations and rules therefore as required in the current manual of survey instructions of the United States Department of the Interior, Bureau of Land Management or by a decree of a Court of Law and/or that the corner points mentioned in lines 3, 4 and 5 above were in conformance with the rules of the Michigan Board of Land Surveyors or by a Decree of a Court of Law; established, re-established, monumented, re-monumented, recovered, found as expressed below:

NOTE: Not more than 4 corners, all in the same town and range, may be recorded on this certificate.

A. Description of original monument and accessories and/or subsequent restoration:

- | | |
|---|---|
| 1831 HARVEY PARKE, CORNER NOT SET IN G.L.O. | 4-1-92 JERRY JONES FOUND 1/2" ROD |
| NO C.S.R. | WIT.-(4)N45°W CENTER 4" MAILBOX POST 26.11' |
| 8-21-67 M.S.H.D. RIGHT-OF-WAY MAPS | (5)EAST 3/4" PIPE 82.20' |
| 6-7-78 JEROME SCHAFER, L.C.R.C. #450 (132) SURVEY | (6)N80°E NAIL IN 15" COTTONWOOD 76.75' |
| FOUND 5/8" ROD | (7)EAST @ ROAD 6.6' |
| WIT.-(1)7.2' WEST OF @ M-30 | |
| (2)N70°E NORTH END 12" BOILER TUBE 73.40' | |
| (3)N40°W NAIL IN TELE. POLE 106.15' | |
| (4)N45°W 2" WELL PIPE FOR MAIL BOX 26.0' | |

B. Description of corner evidence found and/or method applied in restoring or reestablishing corner:


FOUND 1/2"x18" ROD 6.6 FEET WEST OF @ OF P.V.M.T.
FOUND WITNESSES NOS. 4, 5, 6, & 7.
MEASURED SOUTH 544.98 FEET TO M-2, T15N, R1W.

Accepted as best available evidence of the position of the original corner & replaced with Standard Monument.

Corner, E-4 was approved for remonumentation at a Peer Review Committee Meeting on Nov 28, 1994.

C. Description of monument for corner and accessories established to perpetuate locating the position of the corner:

E-4: W 1/4 Cor. Sec. 9
Set 5/8" x 18" re-rod with brass cap stamped "Midland Co. Remon. Cor. PS 9433" in Monument Box.
WITNESSES:
N45°W 26.11' CENTER 4" MAIL BOX POST (4)
EAST 82.20' 3/4" PIPE (5)
N80°E 76.75' - N&T IN 15" COTTONWOOD (6)
N25°W 81.03' CENTER OF FIRE HYD'T.

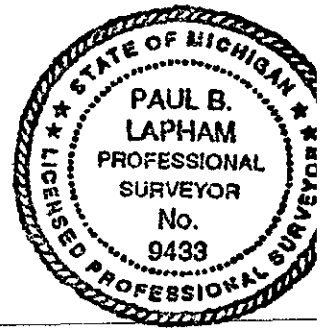

Signed by Paul B. Lapham

Date 12-19-94

Surveyor's Michigan License No. 9433