SURVEY &
REMONUMENTATION

APPROVED LAND CORNER
P.A. 345 OF 1990
MIDLAND COUNTY

APR 28 1995

COMMISSION

11/28/94 929

LAND CORNER RECORDATION CERTIFICATE
Filing Requirement of Act 74, Mich. P.A. 1970

179

STATE OF MICHIGAN
MIDLAND COUNTY
REMONUMENTATION & FILED

21 DEC 94 11:16 A.M.

BEVERLY J THAYER
REGISTER OF DEEDS

Register of Deeds Stamp & File Number

For corners in MIDLAND (County)

	Located In:	Corner Code #
1. Public Land Survey	T 15N R 1E	E-6
	T ___ R ___	
	T ___ R ___	
	T ___ R ___	
2. Property Controlling	S ___ T ___ R ___	
in Section	S ___ T ___ R ___	
3. Miscellaneous	S ___ T ___ R ___	
Property in Sec.	S ___ T ___ R ___	

4. Lot No. _____, Recorded Plat _____
5. Private Claims _____

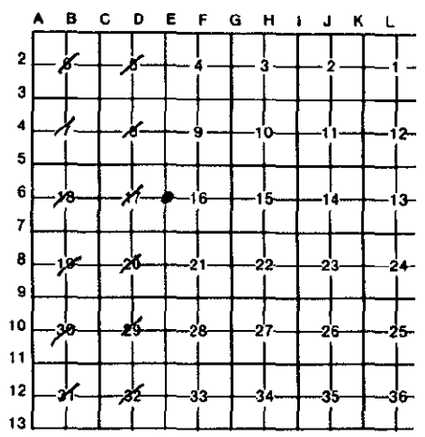

I, PAUL B. LAPHAM, in a field survey on NOVEMBER, 19 94, do hereby certify that under requirements of P.A. 74, Michigan P.A. of 1970, the corner points mentioned in lines 1 and 2 above were in conformance with regulations and rules therefore as required in the current manual of survey instructions of the United States Department of the Interior, Bureau of Land Management or by a decree of a Court of Law and/or that the corner points mentioned in lines 3, 4 and 5 above were in conformance with the rules of the Michigan Board of Land Surveyors or by a Decree of a Court of Law; established, re-established, monumented, re-monumented, recovered, found as expressed below:

NOTE: Not more than 4 corners, all in the same town and range, may be recorded on this certificate.

A. Description of original monument and accessories and/or subsequent restoration:

1831 HARVEY PARKE, CORNER NOT SET IN G.L.O. SURVEY

NO C.S.R.

8-21-67 M.S.H.D. RIGHT-OF-WAY MAPS.

3-4-87 PAUL LAPHAM, L.C.R.C. #638 & (132) L.4, PG.17
FOUND MON. BOX
WIT.-(1)EAST 80.70' TOP CENTER R/W MON.
(2)N35°W 108.80' TAG IN POWER POLE
(3)WEST 48.1' TOP CENTER SOUTH END GALV. CULV.

6-30-92 MARK ROBISON,
FOUND MON. BOX
WITNESSES (1), (2), & (3) ABOVE

B. Description of corner evidence found and/or method applied in restoring or reestablishing corner:

FOUND M.S.H.D. CAP ON 36" PIPE IN MON. BOX
FOUND WITNESSES- #1, 2, & 3.
MEAS. SOUTH 496.0' TO M-4, T15N, R1W

Accepted as best available evidence of the position of the original corner & replaced with Standard Monument.

Corner, E-6 was approved for remonumentation at a Peer Review Committee Meeting on Nov. 28, 19 94.

C. Description of monument for corner and accessories established to perpetuate locating the position of the corner:

E-6: W 1/4 Cor. Sec. 16
Set 5/8" x 18" re-rod with brass cap stamped "Midland Co. Remon. Cor. PS 9433" in Monument Box
WITNESSES:
N35°W 108.80' - N&T IN POWER POLE
WEST 48.10' TOP CENTER SOUTH END GALV. CULV. (3)
EAST 5.7' ℄ PVM'T.

STATE OF MICHIGAN
PAUL B. LAPHAM
PROFESSIONAL SURVEYOR
No. 9433
LICENSED PROFESSIONAL SURVEYOR

Signed by Paul B. Lapham Date 12/19/94

Surveyor's Michigan License No. 9433

FORM APPROVED BY MICHIGAN STATE BOARD OF LAND SURVEYORS, JAN. 28, REVISED MAY 14,