

**SURVEY &  
REMONUMENTATION**

**APPROVED LAND CORNER  
P.A. 345 OF 1990  
MIDLAND COUNTY**

APR 28 1995

**COMMISSION**

**LAND CORNER RECORDATION CERTIFICATE  
Filing Requirement of Act 74, Mich. P.A. 1970**

**180**

STATE OF MICHIGAN  
MIDLAND COUNTY  
REMONUMENTATION & FILED

21 DEC 94 11:16 A.M.

BEVERLY J THAYER  
REGISTER OF DEEDS

**Register of Deeds Stamp & File Number**

For corners in


MIDLAND  
(County)

Located In:

Corner Code #

- |                                       |                          |            |
|---------------------------------------|--------------------------|------------|
| 1. Public Land Survey                 | T <u>15N</u> R <u>1E</u> | <u>E-7</u> |
|                                       | T _____ R _____          | _____      |
|                                       | T _____ R _____          | _____      |
|                                       | T _____ R _____          | _____      |
| 2. Property Controlling<br>in Section | S _____ T _____ R _____  | _____      |
|                                       | S _____ T _____ R _____  | _____      |
| 3. Miscellaneous<br>Property in Sec.  | S _____ T _____ R _____  | _____      |
|                                       | S _____ T _____ R _____  | _____      |

4. Lot No. \_\_\_\_\_, Recorded Plat \_\_\_\_\_  
5. Private Claims \_\_\_\_\_

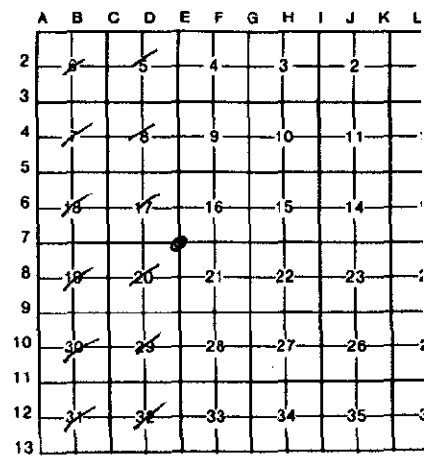

I, PAUL B. LAPHAM, in a field survey on NOVEMBER, 19 94, do hereby certify that under requirements of P.A. 74, Michigan P.A. of 1970, the corner points mentioned in lines 1 and 2 above were in conformance with regulations and rules therefore as required in the current manual of survey instructions of the United States Department of the Interior, Bureau of Land Management or by a decree of a Court of Law and/or that the corner points mentioned in lines 3, 4 and 5 above were in conformance with the rules of the Michigan Board of Land Surveyors or by a Decree of a Court of Law; established, re-established, monumented, re-monumented, recovered, found as expressed below:

**NOTE: Not more than 4 corners, all in the same town and range, may be recorded on this certificate.**

**A. Description of original monument and accessories and/or subsequent restoration:**

1831 HARVEY PARKE  
INT. 7.55 CHS. N. OF SEC. COR.  
WIT.-(1)PINE 12" S74°E 23 LKS.  
(2)PINE 14" N52°E 16 LKS.

2-24-87 LAPHAM, (132) L4, PG 17  
FOUND MON. BOX  
WIT.-(3)S85°E 74.80' CENTER R/W MON.  
(4)S35°W 144.1' TOP CENTER FIRE HYD'T.  
(5)S50°W 87.25' M.S.H.D. TAG IN POWER POLE

1918 GIBBS  
SET GAS PIPE 7.55 CHS. NORTH OF SEC. 12 & 13.  
8-2-67 M.S.H.D., R/W MAPS

3-4-87 LAPHAM, L.C.R.C. #638  
FOUND MON. BOX  
WIT.-(3), (4) & (5) ABOVE

4-17-76 STREJC (132) L.2, PG. 135  
NO WITNESSES

**B. Description of corner evidence found and/or method applied in restoring or reestablishing corner:**

FOUND M.S.H.D. CAPPED IRON IN MON. BOX 8" DEEP. COULD NOT REMOVE.  
FOUND WITNESSES: 3 & 4.  
MEASURED SOUTH 498.50' TO M-5, T15N, R1W 498.30' (620)

Accepted as best available evidence of the position of the original corner & replaced with Standard Monument.

Corner, E-7 was approved for remonumentation at a Peer Review Committee Meeting on Nov. 28, 19 94.

**C. Description of monument for corner and accessories established to perpetuate locating the position of the corner:**

-E-7: Corner common to Sections 16 & 21  
ACCEPTED M.S.H.D. CAPPED IRON IN MONUMENT BOX. AS SUBSTITUTE FOR STANDARD MIDLAND COUNTY MONUMENT.  
WITNESSES:  
S85°E 74.80' CENTER OF R/W MON. (3)  
S35°W 144.10' TOP CENTER OF FIRE HYD'T. (4)  
WEST 55.50' 3" PIPE  
N35°W 87.50' - N&T IN 8" OAK



Signed by Paul B. Lapham  
Surveyor's Michigan License No. 9433

Date 12/19/94