

APPROVED LAND CORNER  
P.A. 345 OF 1990  
MIDLAND COUNTY

249

LAND CORNER RECORDATION CERTIFICATE  
Filing Requirement of Act 74, Mich. P.A. 1970

STATE OF MICHIGAN  
MIDLAND COUNTY  
REMONUMENTATION & FILED

For corners in 2/18/95

14 AUG 95 3:05 P.M.

BEVERLY J THAYER  
REGISTER OF DEEDS

|                                       |             |               |
|---------------------------------------|-------------|---------------|
| <u>MIDLAND</u><br>(County)            | Located In: | Corner Code # |
| 1. Public Land Survey                 | T15N R1E    | E-9           |
|                                       | T R         |               |
|                                       | T R         |               |
|                                       | T R         |               |
| 2. Property Controlling in Section    | S T R       |               |
|                                       | S T R       |               |
| 3. Miscellaneous Property in Sec.     | S T R       |               |
|                                       | S T R       |               |
| 4. Lot No. _____, Recorded Plat _____ |             |               |
| 5. Private Claims _____               |             |               |

Register of Deeds Stamp & File Number

|    |    |    |    |    |    |    |   |   |   |   |   |   |   |
|----|----|----|----|----|----|----|---|---|---|---|---|---|---|
|    | A  | B  | C  | D  | E  | F  | G | H | I | J | K | L | M |
| 2  | 6  | 5  | 4  | 3  | 2  | 1  |   |   |   |   |   |   |   |
| 3  |    |    |    |    |    |    |   |   |   |   |   |   |   |
| 4  | 7  | 8  | 9  | 10 | 11 | 12 |   |   |   |   |   |   |   |
| 5  |    |    |    |    |    |    |   |   |   |   |   |   |   |
| 6  | 18 | 17 | 16 | 15 | 14 | 13 |   |   |   |   |   |   |   |
| 7  |    |    |    |    |    |    |   |   |   |   |   |   |   |
| 8  | 19 | 20 | 21 | 22 | 23 | 24 |   |   |   |   |   |   |   |
| 9  |    |    |    |    |    |    |   |   |   |   |   |   |   |
| 10 | 30 | 29 | 28 | 27 | 26 | 25 |   |   |   |   |   |   |   |
| 11 |    |    |    |    |    |    |   |   |   |   |   |   |   |
| 12 | 31 | 32 | 33 | 34 | 35 | 36 |   |   |   |   |   |   |   |
| 13 |    |    |    |    |    |    |   |   |   |   |   |   |   |

I, PAUL B. LAPHAM, in a field survey on MAY, 1995, do hereby certify that under requirements of P.A. 74, Michigan P.A. of 1970, the corner points mentioned in lines 1 and 2 above were in conformance with regulations and rules therefore as required in the current manual of survey instructions of the United States Department of the Interior, Bureau of Land Management or by a decree of a Court of Law and/or that the corner points mentioned in lines 3, 4 and 5 above were in conformance with the rules of the Michigan Board of Land Surveyors or by a Decree of a Court of Law; established, re-established, monumented, re-monumented, recovered, found as expressed below:

**NOTE: Not more than 4 corners, all in the same town and range, may be recorded on this certificate.**

A. Description of original monument and accessories and/or subsequent restoration:

E-9 WEST SECTION CORNER 21 & 28

1831 HARVEY PARKE, BEECH 11" S25°E 23 LKS., HEMLOCK 6", N18°E 6 LKS.

1918 GIBBS, SET PINE ROOT POST 6.74 CH. NORTH OF COR TO SEC. 13 & 24, T15N, R1W

STATE HIGHWAY, CORNER FALLS IN TURN AROUND, DID NOT LOCATE.

AYRES FILES, NOTES CORNER IS 6.74 CH. NORTH OF S.E. CORNER OF SEC. 13, T15N, R1W.

WITNESS NOTE: Witnesses from above surveys and LCRC's are available in dossier file; which was presented to peer review committee and is on file at the Register of Deeds Office.

B. Description of corner evidence found and/or method applied in restoring or reestablishing corner:

E-9 WEST SECTION CORNER 21 & 28

Measured North 6.74 chains (444.84 feet) from S.E. corner of Section 13, T15N, R1W, on line with E 1/4 corner of Sec. 13. Point falls in asphalt paved turn-around. Did not find anything. Set 5/8" x 18" re-rod at this point according to survey by Gibbs and Ayres file notes. Measured North 2643.42 feet to E-8 (CSR-2653.2)

SURVEY &  
REMONUMENTATION

1995

COMMISSION

Corner, E-9 was approved for remonumentation at a Peer Review Committee Meeting on \_\_\_\_\_, 19\_\_\_\_.

C. Description of monument for corner and accessories established to perpetuate locating the position of the corner:

E-9 WEST SECTION CORNER 21 & 28


Set 5/8" x 18" re-rod with brass cap stamped "Midland Co. Remon. Cor. PS 9433" in Monument Box per survey by Gibbs & file notes by Ayres. Accepted as best available evidence of the accepted position of the corner.

N85°W 37.95' - N&T IN 18" MAPLE (MIDDLE OF TRIPLE)

S45°W 83.40' - N&T IN 16" PINE

S45°E 109.70' - N&T IN POWER POLE

N45°E 71.0' - N&T IN 6" PINE

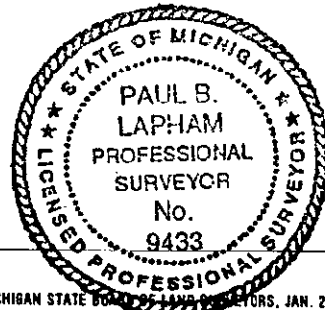

Signed by Paul B. Lapham

Date 9/21/95

Surveyor's Michigan License No. 9433