

SURVEY & REMONUMENTATION

APR 28 1995

COMMISSION

APPROVED LAND CORNER
P.A. 345 OF 1990
MIDLAND COUNTY

12/05/94 JPL

LAND CORNER RECORDATION CERTIFICATE Filing Requirement of Act 74, Mich. P.A. 1970

181

For corners in

MIDLAND <small>(County)</small>	Located In:	Corner Code #	
1. Public Land Survey	T <u>15N</u> R <u>1E</u>	<u>E-10</u>	
	T _____ R _____	_____	
	T _____ R _____	_____	
	T _____ R _____	_____	
2. Property Controlling in Section	S _____ T _____ R _____	_____	
	S _____ T _____ R _____	_____	
3. Miscellaneous Property in Sec.	S _____ T _____ R _____	_____	
	S _____ T _____ R _____	_____	
4. Lot No. _____, Recorded Plat _____			
5. Private Claims _____			

STATE OF MICHIGAN
MIDLAND COUNTY
REMONUMENTATION & FILED

21 DEC 94 11:17 A.M.

BEVERLY J THAYER
REGISTER OF DEEDS

Register of Deeds Stamp & File Number

I, PAUL B. LAPHAM, in a field survey on NOVEMBER, 19 94, do hereby certify that under requirements of P.A. 74, Michigan P.A. of 1970, the corner points mentioned in lines 1 and 2 above were in conformance with regulations and rules therefore as required in the current manual of survey instructions of the United States Department of the Interior, Bureau of Land Management or by a decree of a Court of Law and/or that the corner points mentioned in lines 3, 4 and 5 above were in conformance with the rules of the Michigan Board of Land Surveyors or by a Decree of a Court of Law; established, re-established, monumented, re-monumented, recovered, found as expressed below:

NOTE: Not more than 4 corners, all in the same town and range, may be recorded on this certificate.

A. Description of original monument and accessories and/or subsequent restoration:

1831 HARVEY PARKE
CORNER NOT SET IN G.L.O. SURVEY
NO C.S.R.

8-21-67 M.S. H.D. R/W MAPS.

3-31-73 EUGENE GOSS, L.C.R.C. #219
R.R. SPIKE
WIT.-NW 64.0' TO FACE OF POWER POLE
SW 99.2' TO S.E. BLDG. COR.
9.0' WEST OF Q M-30 3.0' N. OF
Q PRICE ROAD

4-19-78 JEROME SCHAFER, (132) SURVEY
FOUND 3/4" PIPE IN MON. BOX
WIT.-(1)N45°E N&T IN TELE. POLE 66.48'
(2)N45°W N&T IN POWER POLE 76.93'

4-11-90 WILLIAM RUDELL, L.C.R.C. #681
SET CAPPED "T" IRON FROM PREVIOUS SURVEYS.
(NOTED THAT CORNER DOES NOT CHECK LOCATION INDICATED
BY GOSS IN 1973)
WIT.-(2)NW 76.76' N&T IN POWER POLE
(3)SSE 186.68' N&T IN POWER POLE
(4)SSW 144.12' N&T IN TELE. POLE
(5)NE 59.70' N&T IN POWER POLE

B. Description of corner evidence found and/or method applied in restoring or reestablishing corner:

FOUND CAPPED "T" IRON OVER 3/4" PIPE IN PAVED ROAD. CORNER IS 391.55' NORTH OF M-8, T15N, R1W AND 2641.53' NORTH OF E-11 PER RUDELL L.C.R.C.
FOUND WITNESSES - 2, 3, 4, & 5.


Accepted as best available evidence of the position of the original corner & replaced with Standard Monument.

Corner, E-10 was approved for remonumentation at a Peer Review Committee Meeting on 12-05, 19 94.

C. Description of monument for corner and accessories established to perpetuate locating the position of the corner:

E-10: W 1/4 Cor. Sec. 28
Set 5/8" x 18" re-rod with brass cap stamped "Midland Co. Remon. Cor. PS 9433" in Monument Box.

WITNESSES:
S20°E 186.68' - N&T IN POWER POLE (3)
S20°W 144.12' - N&T IN TELE. POLE (4)
N45°W 76.76' - N&T IN POWER POLE (2)
N20°E 59.70' - N&T IN POWER POLE (5)

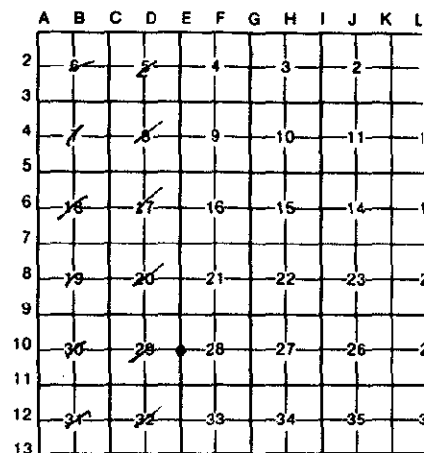

Signed by Paul B. Lapham
Surveyor's Michigan License No. 9433

Date 12/19/94

