

REMONUMENTATION

APPROVED LAND CORNER
P.A. 345 OF 1990
MIDLAND COUNTY

APR 28 1995

COMMISSION

99

9/21/94 JLP

LAND CORNER RECORDATION CERTIFICATE
Filing Requirement of Act 74, Mich. P.A. 1970

For corners in

<u>MIDLAND</u> (County)	Located In:	Corner Code #
Public Land Survey	T <u>15N</u> R <u>1E</u>	<u>K-1</u>
	T _____ R _____	_____
	T _____ R _____	_____
	T _____ R _____	_____
Property Controlling	S _____ T _____ R _____	_____
in Section	S _____ T _____ R _____	_____
Miscellaneous	S _____ T _____ R _____	_____
Property in Sec.	S _____ T _____ R _____	_____

STATE OF MICHIGAN
MIDLAND COUNTY
FILED REHON

28 SEP 94 3:32 P.M.

BEVERLY J THAYER
REGISTER OF DEEDS

Register of Deeds Stamp & File Number

1. Lot No. _____, Recorded Plat _____
2. Private Claims _____

A	B	C	D	E	F	G	H	I	J	K	L	M
2	6	5	4	3	2	1						
3												
4	7	8	9	10	11	12						
5												
6	13	17	16	15	14	13						
7												
8	19	20	21	22	23	24						
9												
10	30	29	28	27	26	25						
11												
12	31	32	33	34	35	36						
13												

PAUL B. LAPHAM, in a field survey on MAY, 19 94

to hereby certify that under requirements of P.A. 74, Michigan P.A. of 1970, the corner points mentioned in lines 1 and 2 above were in conformance with regulations and rules therefore as required in the current manual of survey instructions of the United States Department of the Interior, Bureau of Land Management or by a decree of a Court of Law and/or that the corner points mentioned in lines 3, 4 and 5 above were in conformance with the rules of the Michigan Board of Land Surveyors or by a Decree of a Court of Law; established, re-established, monumented, re-monumented, recovered, found as expressed below:

NOTE: Not more than 4 corners, all in the same town and range, may be recorded on this certificate.

A. Description of original monument and accessories and/or subsequent restoration:

- K-1: North Section Corner common to Sections 1 and 2
1831 - Parke, Int Bdy 12 lks W, Hemlock 30" S 60°W 50 lks, Sugar 11" S 45°E 30 lks
- 3-4-53 - 1" x 3" Iron Bar Ayres Associates files
 - (1) N 45°E SE Cor. School 118.5'
 - (2) S 45°E @ 18" Maple 80.0'
 - (3) S 45°E @ 36" Elm 51.0'
 - (4) N 45°W face, Power Pole 63.6', (5) 7.75' E to SW Cor. Sec. 36, Hope Township
- 10-9-67 - Found 1" x 3" Iron Bar, raised to surface w/ 3/4" Iron Pipe, Ayres Assoc. file Bk 59 Pg 77
 - (4) N 45°W P.K. & Tag in PP 64.50 (Rec)
 - (6) S 75°E P.K. & Tag in TP 63.65'
 - (7) N 45°E @ Tele Cable Marker 64.43', (5) 7.83' W of Mon. Box SW Cor. Sec. 36, Hope Twp.
- 10-11-67 - M. H. Hunter, Unrecorded survey, No Witnesses

B. Description of corner evidence found and/or method applied in restoring or reestablishing corner:


- K-1: North Section Corner common to Sections 1 and 2
Found 1/2" Bar in 3/4" x 24" Pipe in Mon. Box.
Replaced with 5/8" x 18" Re-rod & Std. Midland County Remonumentation Cap Marked PS#9433
Found witnesses 5, 6 and possibly 4.

Accepted as best available evidence of the position of the original corner & replaced with Standard Monument.

Corner K-1 was approved for remonumentation at a Peer Review Committee Meeting on SEPT. 21, 1994.

C. Description of monument for corner and accessories established to perpetuate locating the position of the corner:

- K-1: North Section Corner common to Sections 1 and 2
Set 5/8" x 36" re-rod with brass cap stamped "Midland Co. Remon. Cor. PS 9433" in Mon. Box.
N 45°W, 64.50' - PK & Tag in Power Pole (4)
S 75°E, 63.65' - PK & Tag in Tele. Pole (6)
N 45°E, 103.00' - Nail & Disk in West Root of 30" Maple
7.83' West of Mon. Box for S.W. Corner, Section 36, Hope Township

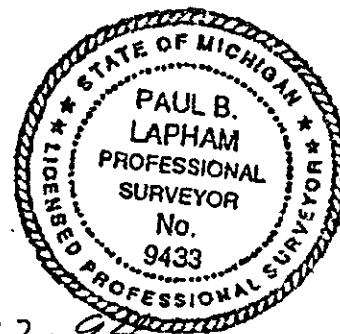

Signed by Paul B. Lapham Date 9-22-94
Surveyor's Michigan License No. 9433