

**SURVEY &
REMONUMENTATION**

APPROVED LAND CORNER
P.A. 345 OF 1990
MIDLAND COUNTY

APR 28 1995

100

COMMISSION

9/21/94 JBL **LAND CORNER RECORDATION CERTIFICATE**
Filing Requirement of Act 74, Mich. P.A. 1970

or corners in

| MIDLAND (County) | Located In: | Corner Code # |
|------------------------------------|--------------------------|---------------|
| Public Land Survey | T <u>15N</u> R <u>1E</u> | <u>K-2</u> |
| | T _____ R _____ | _____ |
| | T _____ R _____ | _____ |
| | T _____ R _____ | _____ |
| Property Controlling in Section | S _____ T _____ R _____ | _____ |
| Miscellaneous Property in Sec. | S _____ T _____ R _____ | _____ |

STATE OF MICHIGAN
MIDLAND COUNTY
FILED *REMON*

28 SEP 94 3:32 P.M.

BEVERLY J THAYER
REGISTER OF DEEDS

Register of Deeds Stamp & File Number

Lot No. _____, Recorded Plat _____
Private Claims _____

| | A | B | C | D | E | F | G | H | I | J | K | L | M |
|----|----|----|----|----|----|----|---|---|---|---|---|---|---|
| 2 | 6 | 5 | 4 | 3 | 2 | 1 | | | | | | | |
| 3 | | | | | | | | | | | | | |
| 4 | 7 | 8 | 9 | 10 | 11 | 12 | | | | | | | |
| 5 | | | | | | | | | | | | | |
| 6 | 18 | 17 | 16 | 15 | 14 | 13 | | | | | | | |
| 7 | | | | | | | | | | | | | |
| 8 | 19 | 20 | 21 | 22 | 23 | 24 | | | | | | | |
| 9 | | | | | | | | | | | | | |
| 10 | 30 | 29 | 28 | 27 | 26 | 25 | | | | | | | |
| 11 | | | | | | | | | | | | | |
| 12 | 31 | 32 | 33 | 34 | 35 | 36 | | | | | | | |
| 13 | | | | | | | | | | | | | |

PAUL B. LAPHAM in a field survey on MAY, 19 94,
do hereby certify that under requirements of P.A. 74, Michigan P.A. of 1970, the corner points mentioned
in lines 1 and 2 above were in conformance with regulations and rules therefore as required in the
current manual of survey instructions of the United States Department of the Interior, Bureau of Land
Management or by a decree of a Court of Law and/or that the corner points mentioned in lines 3, 4 and 5
above were in conformance with the rules of the Michigan Board of Land Surveyors or by a Decree of a
Court of Law; established, re-established, monumented, re-monumented, recovered, found as
expressed below:

**NOTE: Not more than 4 corners, all in the same town and range, may be recorded
on this certificate.**

Description of original monument and accessories and/or subsequent restoration:

K-2: 1/4 Corner common to Sections 1 and 2
1831 - Parke, Set Post, Pine 36" N 41°E 25 lks, Hemlock 18" S 12°W 13 lks
No C.S.R.

No Recorded Surveys

10-11-67 - Merrill Hunter, Unrecorded survey from Ayres file, Survey Data - No Witnesses

10-11-67 - Corner Witness, Ayres files, Bk 59, Pg 78

4-16-73 - Jerome Schafer, Unrecorded survey, Survey Data - No Witnesses

Description of corner evidence found and/or method applied in restoring or reestablishing corner:


K-2: 1/4 Corner common to Sections 1 and 2
Measured angle (89°31') from North line of Section & distance South (2441.8') From 1-2 Section Corner.
Found 3/4" x 18" Pipe under asphalt, 2' West of East edge and 1.5" deep.
Set 5/8" x 18" Iron and Monument Box.
This corner fits unrecorded survey by Hunter (See Above)

Accepted as best available evidence of the position of the original corner & replaced with Standard Monument.

Corner K-2 was approved for remonumentation at a Peer Review Committee Meeting on SEPT 21, 1994.

Description of monument for corner and accessories established to perpetuate locating the position of the corner:

K-2: 1/4 Corner common to Sections 1 and 2
Set 5/8" x 35" re-rod with brass cap stamped "Midland Co. Remon. Cor. PS 9433" in Mon. Box.
S 79°W, 43.5' - Top Center of 48" Conc. Pipe
S 60°E, 99.2' - N.W. Corner of House #4240
N 18°W, 156.75' - B.M. Tag in Power Pole
EAST, 2.15' - East edge of Asphalt Pavement

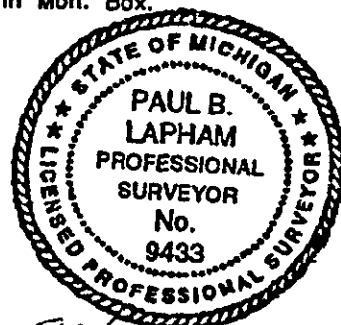

Signed by Paul B. Lapham

Date 9-22-94

Surveyor's Michigan License No. 9433