

APPROVED LAND CORNER
P.A. 345 OF 1990
MIDLAND COUNTY

APR 28 1995
COMMISSION

102

9/21/94

LAND CORNER RECORDATION CERTIFICATE
Filing Requirement of Act 74, Mich. P.A. 1970

For corners in

MIDLAND (County)	Located In:	Corner Code #
1. Public Land Survey	T <u>15N</u> R <u>1E</u>	<u>L-11</u>
	T _____ R _____	_____
	T _____ R _____	_____
	T _____ R _____	_____
2. Property Controlling in Section	S _____ T _____ R _____	_____
	S _____ T _____ R _____	_____
3. Miscellaneous Property in Sec.	S _____ T _____ R _____	_____
	S _____ T _____ R _____	_____

STATE OF MICHIGAN
MIDLAND COUNTY
FILED *QREMON*

28 SEP 94 3:33 P.M.

BEVERLY J THAYER
REGISTER OF DEEDS

Register of Deeds Stamp & File Number

4. Lot No. _____, Recorded Plat _____
5. Private Claims _____

	A	B	C	D	E	F	G	H	I	J	K	L	M
2	6	5	4	3	2	1							
3													
4	7	8	9	10	11	12							
5													
6	18	17	16	15	14	13							
7													
8	19	20	21	22	23	24							
9													
10	30	29	28	27	26	25							
11													
12	31	32	33	34	35	36							
13													

I, PAUL B. LAPHAM, in a field survey on JUNE, 19 94, do hereby certify that under requirements of P.A. 74, Michigan P.A. of 1970, the corner points mentioned in lines 1 and 2 above were in conformance with regulations and rules therefore as required in the current manual of survey instructions of the United States Department of the Interior, Bureau of Land Management or by a decree of a Court of Law and/or that the corner points mentioned in lines 3, 4 and 5 above were in conformance with the rules of the Michigan Board of Land Surveyors or by a Decree of a Court of Law; established, re-established, monumented, re-monumented, recovered, found as expressed below:

NOTE: Not more than 4 corners, all in the same town and range, may be recorded on this certificate.

A. Description of original monument and accessories and/or subsequent restoration:

- L-11: 1/4 Corner common to Sections 25 and 36
- 1831 - Parke Set 1/4 Sec. Post on True Line, Tamarack 10" N 25°E, 90 lks
- 11/27/01 - Gibbs Set post for Corner, located from J.W. Campbell's fence C.S.R. Bk1-P.22
- 10/25/78 - Jerome Schafer, Found 1/2" Pipe (132) 2-706
 - (1) NORTH, Tag in Power Pole, 45.32'
 - (2) S 45°E, Nail in Tele. Pole, 56.45'
 - (3) S 45°W, Nail in 24" Oak, 98.50'
- 10/26/78 - Jerome Schafer (Witnesses as above) L.C.R.C. 11-1-78
- 5/6/90 - Duane Ledy (132) 4-728
 - (1) NORTH 46.88' - P.K. Nail in Power Pole (2) SE, 56.47' - P.K. Nail in Guy Pole
 - (4) SOUTH, 47.90' - Ⓢ Stop Sign Post (5) SW, 95.19' - Spike in 10" Oak

B. Description of corner evidence found and/or method applied in restoring or reestablishing corner:


- L-11: 1/4 Corner common to Sections 25 and 36
- Found 5/8" Pipe on a 1/2" Re-bar, Excavated to 3 feet and found no further evidence.
- Found Recorded Witnesses 1, 2 & 5

Accepted as best available evidence of the position of the original corner & replaced with Standard Monument.

1/4 Corner L-11 was approved for remonumentation at a Peer Review Committee Meeting on SEPT. 21, 1994.

C. Description of monument for corner and accessories established to perpetuate locating the position of the corner:

- L-11: 1/4 Corner common to Sections 25 and 36
- Set 5/8" x 18" re-rod with brass cap stamped "Midland Co. Remon. Cor. PS 9433" in Mon. Box.
- N 64°E, 57.00' - Nail & Tag in 8" Ash
- NORTH, 46.88' - P.K. Nail in Power Pole (1)
- S 45°E, 56.45' - Nail in Tele. Pole (2)
- SW, 95.19' - Spike in 10" Oak (5)

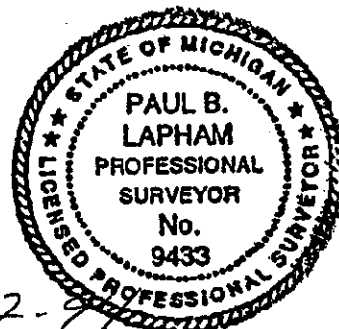

Signed by Paul B. Lapham Date 9-22-94

Surveyor's Michigan License No. 9433