

APPROVED LAND CORNER  
P.A. 345 OF 1990  
MIDLAND COUNTY

REMON. COR. C-4, LARKIN TWP.  
LAND CORNER RECORDATION CERTIFICATE  
Filing Requirement of Act 74, Mich. P.A. 1970

460

For corners in  
Midland  
(County)

- |                                       |                   |               |
|---------------------------------------|-------------------|---------------|
|                                       | Located in:       | Corner Code # |
| 1. Public Land Survey                 | T 15N R 2E        | C-4           |
|                                       | T ___ R ___       | _____         |
|                                       | T ___ R ___       | _____         |
|                                       | T ___ R ___       | _____         |
| 2. Property Controlling in Section    | S ___ T ___ R ___ | _____         |
|                                       | S ___ T ___ R ___ | _____         |
| 3. Miscellaneous Property in Sec.     | S ___ T ___ R ___ | _____         |
|                                       | S ___ T ___ R ___ | _____         |
| 4. Lot No. _____, Recorded Plat _____ |                   |               |
| 5. Private Claims _____               |                   |               |

STATE OF MICHIGAN  
MIDLAND COUNTY  
REMONUMENTATION & FILED

12/15/1999 8:26:43 AM

SCOTT I. HAINES  
REGISTER OF DEEDS

Register of Deeds Stamp & File Number


I, **RODNEY CLAYPOOL**, in a field survey on June 16, 1998, do hereby certify that under requirements of P.A. 74, Michigan P.A. of 1970, the corner points mentioned on lines 1 and 2 above were in conformance with regulations and rules therefore as required in the current manual of survey instructions of the United States Department of the Interior, Bureau of Land Management or by a decree of a Court of Law and/or that the corner points mentioned in lines 3, 4 and 5 above were in conformance with the rules of the Michigan Board of Land Surveyors or by a Decree of a Court of Law; re-established, monumented, re-monumented, recovered, found as expressed below:

NOTE: Not more than 2 corners, all in the same town and range, may be recorded on this certificate.

	A	B	C	D	E	F	G	H	I	J	K	L	M
2		6	5	4	3	2	1						
3													
4		7	8	9	10	11	12						
5													
6		18	17	16	15	14	13						
7													
8		19	20	21	22	23	24						
9													
10		30	29	28	27	26	25						
11													
12		31	32	33	34	35	36						
13													

A. Description of original monument and accessories and/or subsequent restoration:

- C-4 1/4 Corner common to Sections 7 and 8
- Survey by Glo, 1830's, set post  
Survey by F. Gibbs, 1909, set post (kettle over)  
Survey by Edmands Engineering, 1976, 1/2" iron  
Survey by Hunter-Whittier, 1976, found 3/4" pipe in iron kettle  
Survey by D. Ledy, 1985, found 3/4" pipe  
Survey by Ayres Associates, 1997, found 3/4" pipe

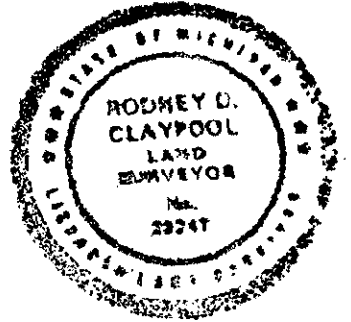

B. Description of corner evidence found and/or method applied in restoring or reestablishing corner:

- C-4 1/4 Corner common to Sections 7 and 8
- Found 3/4" pipe per surveys by F. Gibbs, Edmands Engineering, Hunter-Whittier, D. Ledy and Ayres Associates.

C. Description of monument for corner and accessories established to perpetuate locating the position of the corner:

- C-4 1/4 Corner common to Sections 7 and 8
- Found 3/4" pipe per surveys by F. Gibbs, Edmands Engineering, Hunter-Whittier, D. Ledy and Ayres Associates, replaced pipe with 5/8" rod and brass cap stamped Midland Co. Remon Cor PS 29241 and is accepted as the best available evidence of the position of the accepted corner.
- S 75 Deg W, 100.42', nail in power pole. Rec. 100.48, 100.54  
S 20 Deg E, 113.60', nail in power pole. Rec. 113.62  
S 80 Deg W, 48.93', pk nail in power pole  
N 80 Deg E, 46.41', nail & plastic disc in 10" Maple

Signed by Rodney D. Claypool  
Surveyor's Michigan License No. 29241

Date 12-11-99  
Form approved by Michigan State Board of Land Surveyors, Jan. 28, 1971  
Revised May 14, 1971  
Revised Jan., 1983

SURVEY &  
REMONUMENTATION

FEB 09 2000

SECTION